


## Lot Servicing

2747 GUNN RD

PID: 027953190

**Lot:** PCL D, **Block:** 62, **Plan:** 902, **DL:** 629 (BB946875)

SERVICE	SIZE	MATERIAL	INSTALLED DATE	LOCATION	DETAILS
SANITARY	100MM	PVC		17.8M E OF MH# 13-A; 96.3M W OF MH# MK23-A; 21.031M E OF W PL	ELEV OF INVERT @ P/L 685.282

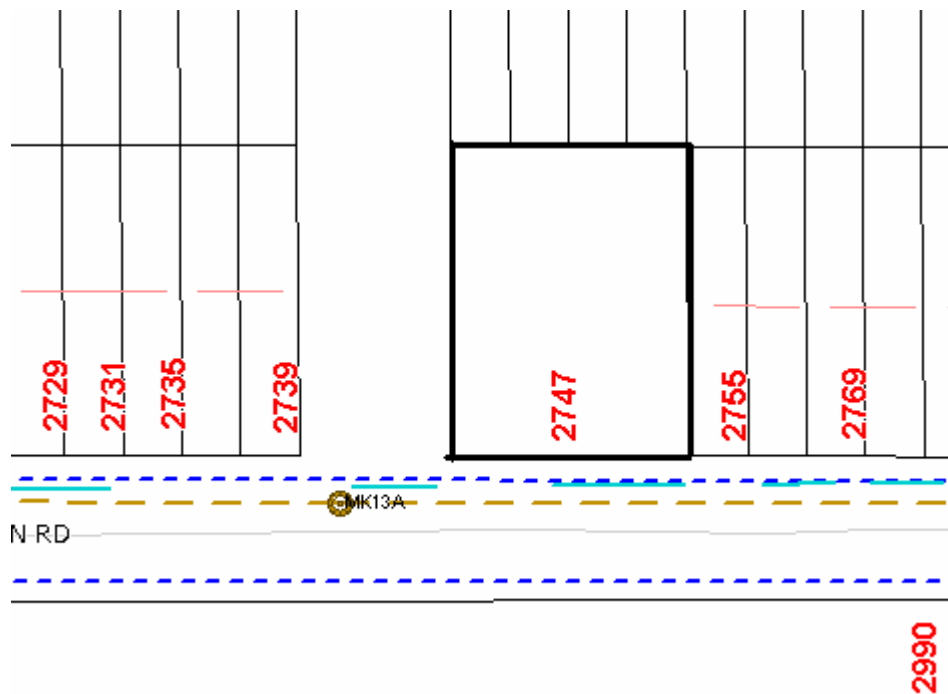

Accuracy not guaranteed unless confirmed by site inspection and/or investigation.  
Connection location between main and property line only.