



City of Prince George
History Sheet

PID:	027957161
SD/MU:	
WO:	

Civic Address: 3330 22nd Ave

Legal Description: Lot: PCL D (CA1176458 District Lot: 936 Plan: 10868

Service Type	Diameter (mm)	Material	Invert Elev at main (m)	Invert Elev at property line (m)	Invert Elev at service end (m)	Distance into property (m)	Installation Date
Sanitary - (S1)	100mm	AC	-	-	-	-	December 1968
Sanitary - (S2)	200mm	AC	-	-	-	-	December 1968
Sanitary - (S3)	100mm	AC	-	-	-	-	December 1937
Sanitary - (S4)	200mm	AC	-	-	-	-	December 1967
Sanitary - (S5)	100mm	AC	-	-	-	-	December 1968
Sanitary - (S6)	100mm	AC	-	-	-	-	December 1968
Sanitary - (S7)	Unknown	AC	-	-	-	-	December 1975
Water - (W1)	100mm	Steel	-	-	-	-	December 1961
Water - (W2)	200mm	AC	-	-	-	-	December 1961
Water - (W3)	150mm	AC	-	-	-	-	October 1982
Water - (W4)	150mm	AC	-	-	-	-	December 1966
Water - (W5)	200mm	AC	-	-	-	-	December 1966
Water - (W6)	150mm	AC	-	-	-	-	December 1966
Water - (W7)	150mm	AC	-	-	-	-	December 1966
Water - (W8)	Unknown	CI	-	-	-	-	December 1964
Water - (W9)	150mm	CI	-	-	-	-	October 1982
Storm - (D1)	200mm	AC	-	-	-	-	December 1982
Storm - (D2)	Unknown	AC	-	-	-	-	December 1966

Service Connection Location				Sanitary (m)	Storm (m)
Distance from downstream San MH	3146	towards upstream San MH	3147	75.2	
200mm Sanitary service connected to San Mh3146					
100mm Sanitary service connected to San MH3247					
200Sanitary service3 connected to San MH3250					
Distance from downstream San MH	3367	towards upstream San MH	3250	113.90	
Distance from downstream San MH	3145	towards upstream San MH	3146	35.40	


Power	Size	Communications	Size	Cable	Size	Gas	Size
BC Hydro	-	Telus	-	Shaw	-	FortisBC	-
Underground Service		Underground Service		Underground Service			

Installed by:				Survey Date:	-
Comments:					

NOT TO SCALE The information contained herein is for internal use only.
Not to be relied on unless confirmed by site inspection and/or investigation.

NOT TO SCALE

THE CITY OF PRINCE GEORGE DOES NOT REPRESENT OR GUARANTEE THAT THE INFORMATION CONTAINED IN THIS DOCUMENT IS ACCURATE OR RELIABLE, AND ANY INDIVIDUAL WHO RELIES ON THIS INFORMATION IN THIS DOCUMENT DOES SO AT THEIR OWN RISK.

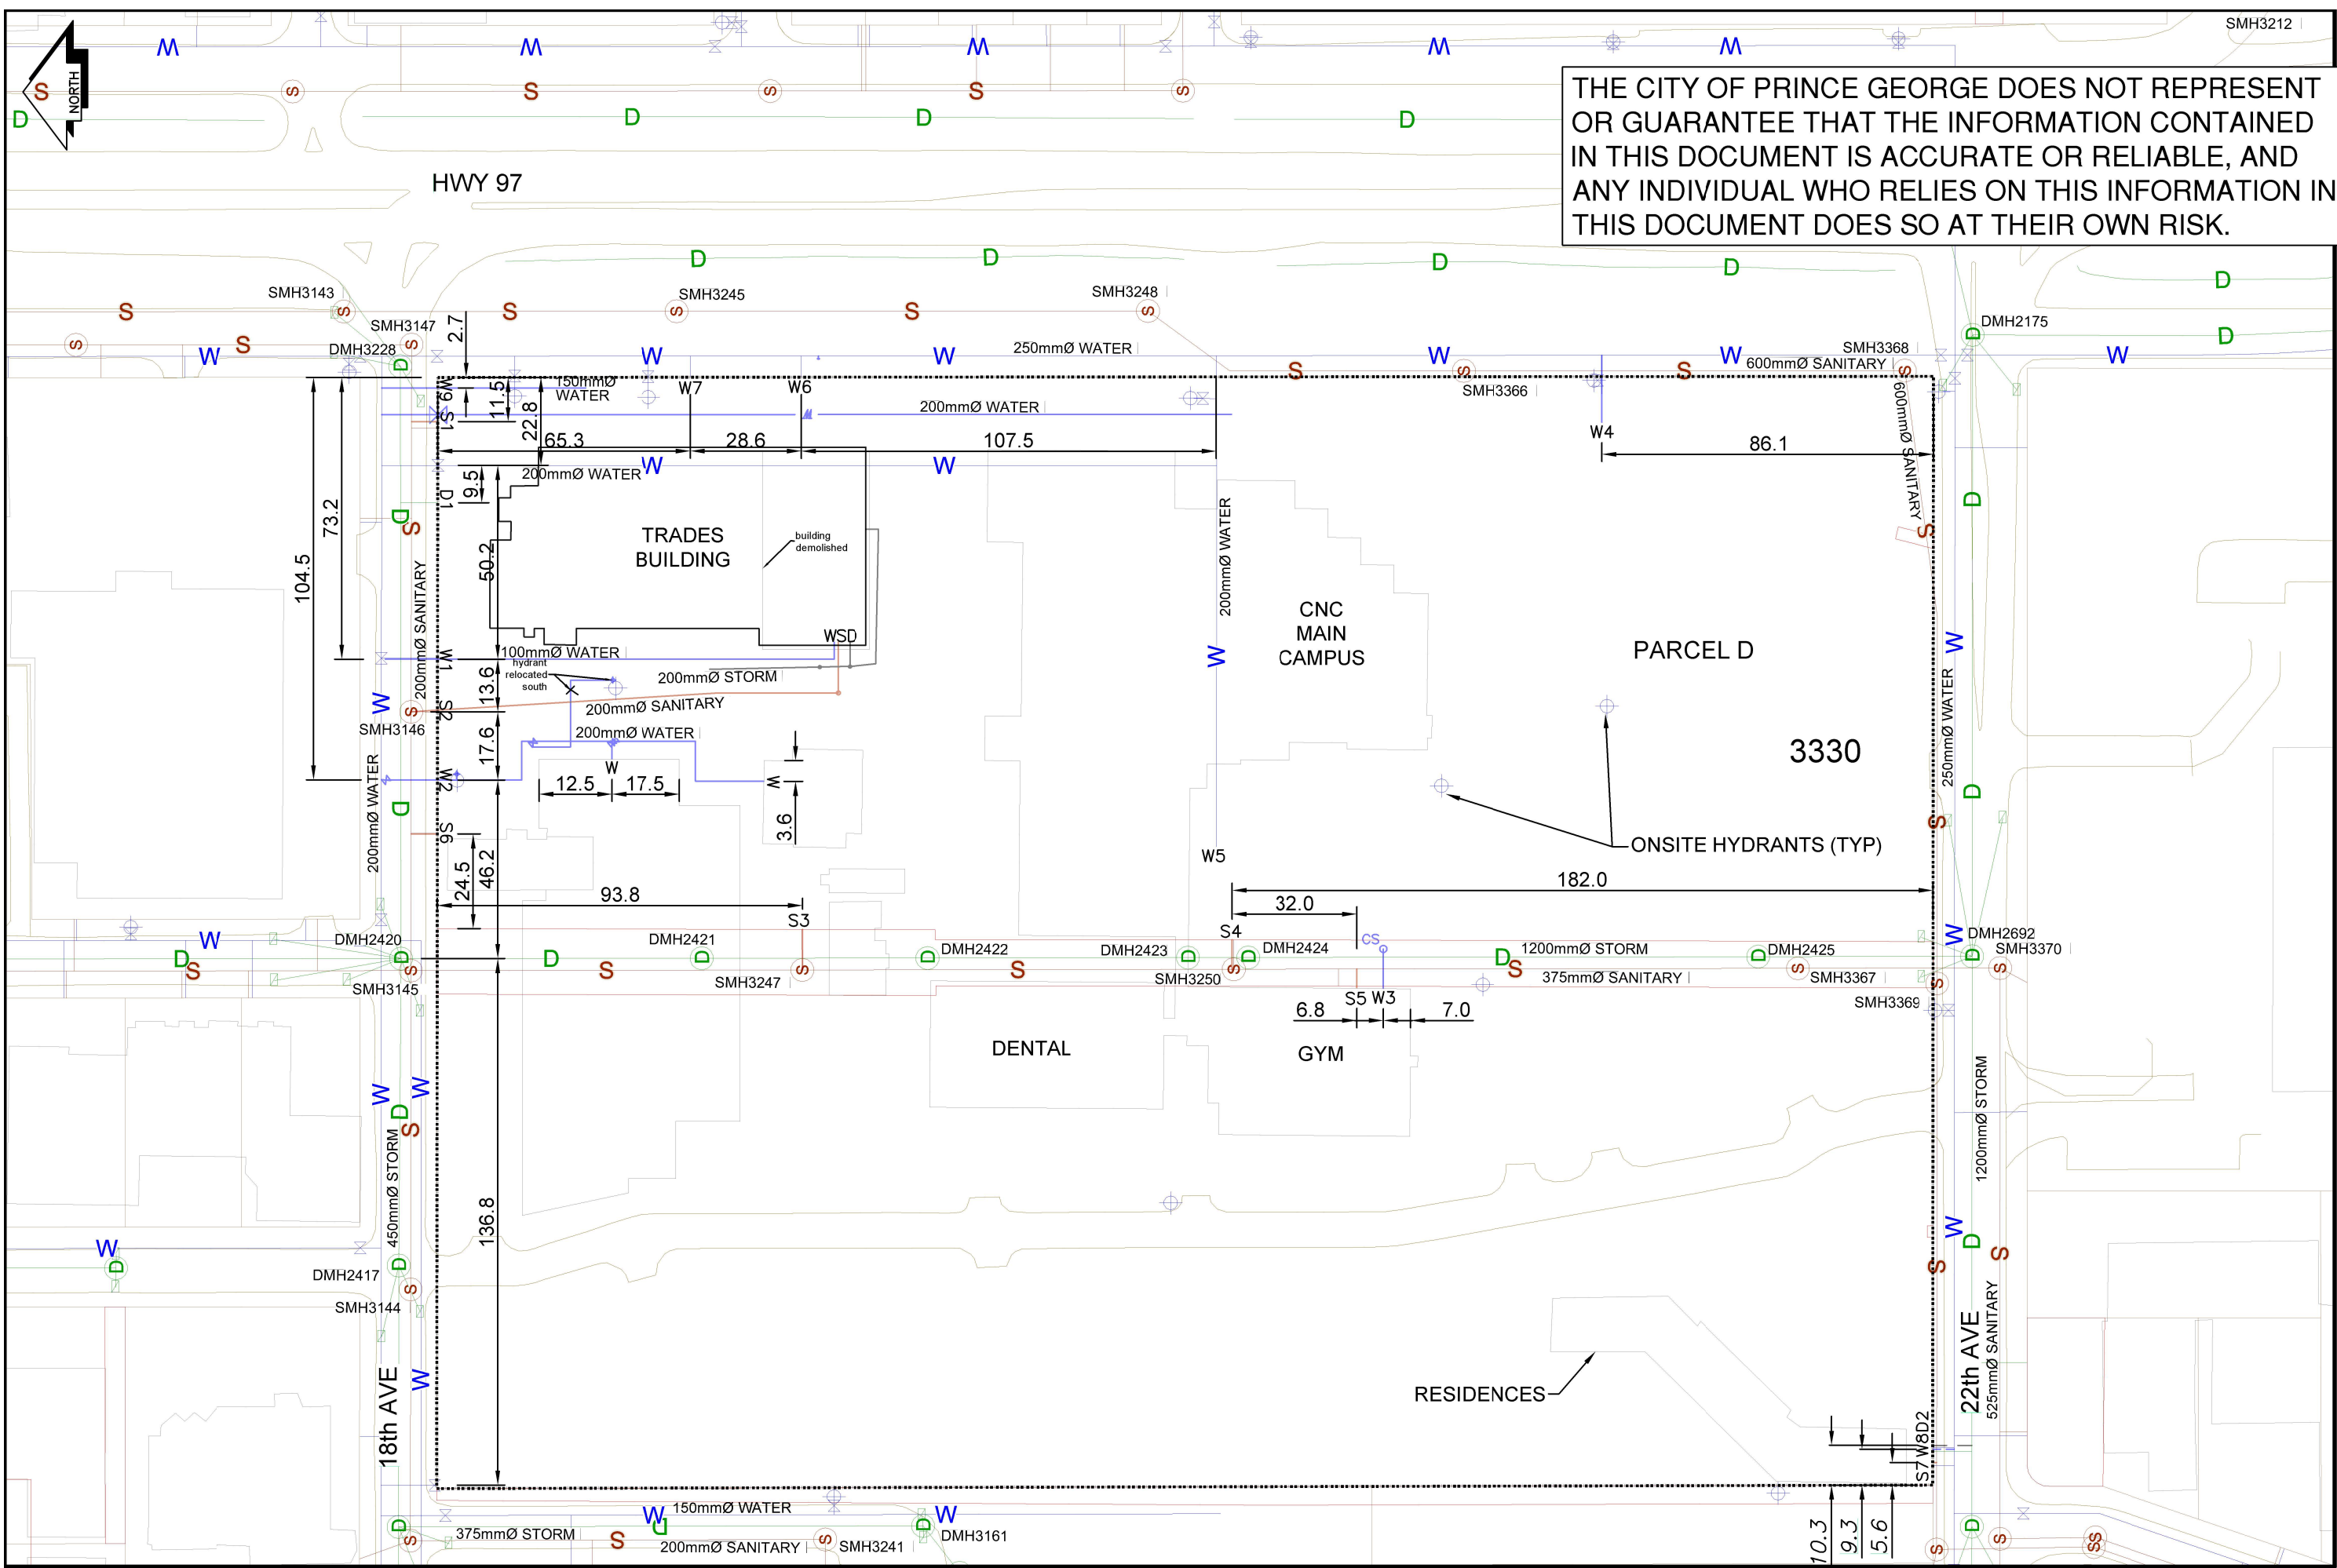

LEGEND:

CURB STOP	WATER SERVICE	STORM SERVICE
CLEAN OUT	SANITARY SERVICE	GAS