


Lot Servicing

1990 RENWICK CRES

PID: 027960706

Lot: PCL A, **Block:** 123, **Plan:** 1268, **DL:** 343 (BB1085515)

SERVICE	SIZE	MATERIAL	INSTALLED DATE	LOCATION	DETAILS
WATER	20MM	CU		FR SE CORNER BLDG 11.58M S AND 2.438M W	CASH RECEIPT NUMBER 729
SANITARY	UNKNOWN	UNKNOWN		4.815M W OF SE COR PL	CLEANOUT 4.815MW OF SE

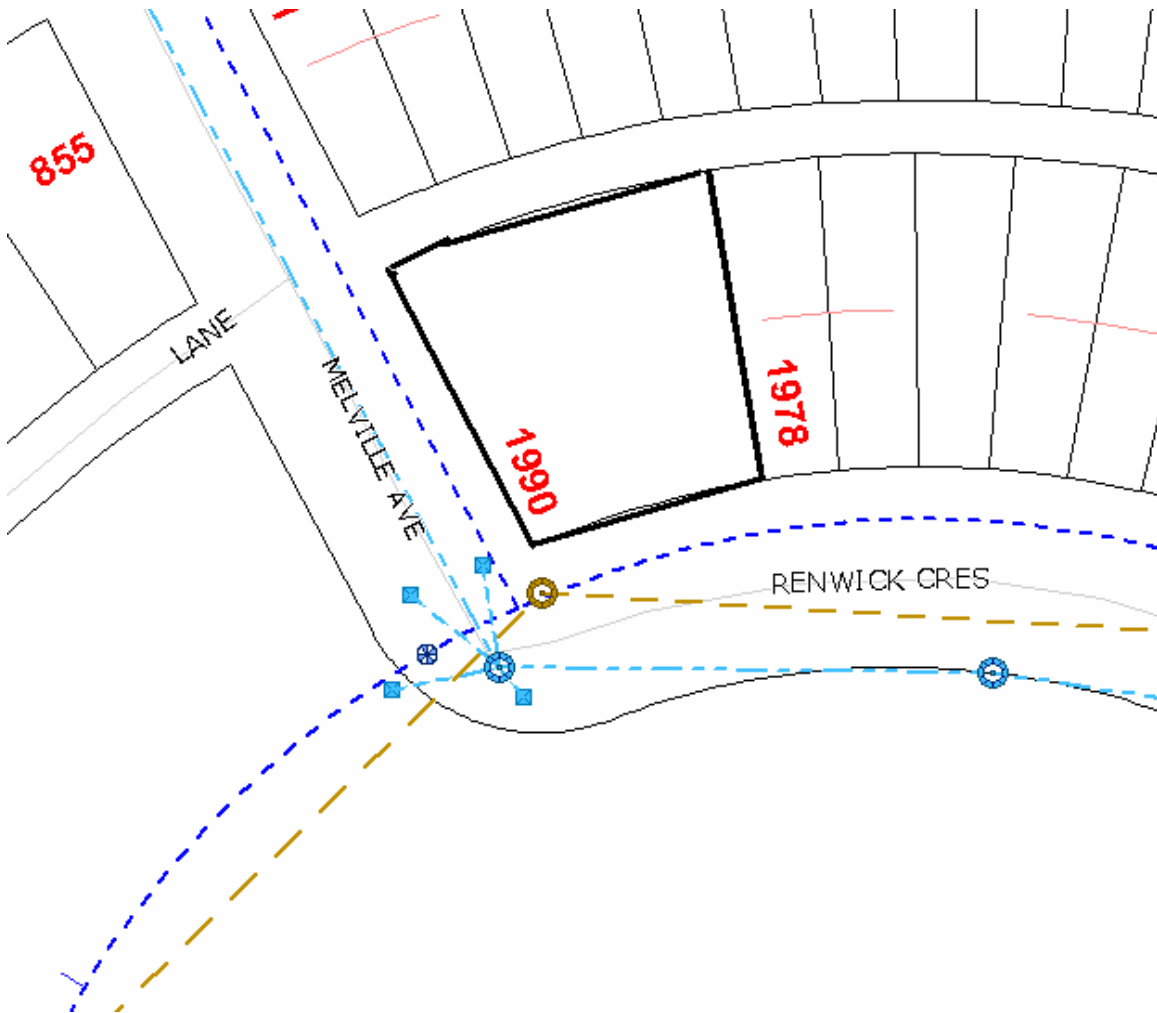

Accuracy not guaranteed unless confirmed by site inspection and/or investigation.
Connection location between main and property line only.