

City of Prince George

HISTORY SHEET

PID: **027961460**

Scale: 1:2000

Legal: LOT 1

D.L.: 753

PLAN: BCP41482

Address: **5920 O'GRADY RD**

Sanitary Connection:#	SIZE: N/A	MATERIAL: N/A	INV. AT \mathbb{R} N/A
-----------------------	-----------	---------------	--------------------------

Water Connection:#	SIZE: 150mm \emptyset	MATERIAL: PVC	INV. AT \mathbb{R} 648.64m
--------------------	-------------------------	---------------	------------------------------

Storm Connection:#	SIZE: 300mm \emptyset	MATERIAL: PVC	INV. AT \mathbb{R} 648.96m CONNECTED
--------------------	-------------------------	---------------	--

Cash Receipt No's:	WATER	SANITARY	STORM
--------------------	-------	----------	-------

CURB FROM PROPERTY LINE	5m	PAVEMENT WIDTH	10m
-------------------------	----	----------------	-----

HYDRO	3 - 75mm DB2	U/G CONNECTION	✓
-------	--------------	----------------	---

TELEPHONE	2 - 100mm DB2	U/G CONNECTION	✓
-----------	---------------	----------------	---


SHAW	1 - 100mm DB2	U/G CONNECTION	✓
------	---------------	----------------	---

Information Sheets: REF. DWGS. L&M ENGINEERING LTD. JOB. 1432-01-04 DWGS.

Comments:	CS CURB STOP CO CLEAN OUT	SOW WATER SERVICE STORM SERVICE SANITARY SERVICE	HYDRO SERVICE CABLE SERVICE TELECOMMUNICATIONS	GAS GAS E ELECTRICAL
-----------	------------------------------	---	--	----------------------------

THE INFORMATION CONTAINED HEREIN IS FOR INTERNAL USE ONLY.

NOT TO BE RELIED UPON UNLESS CONFIRMED BY THE SITE INSPECTION AND/OR INVESTIGATION

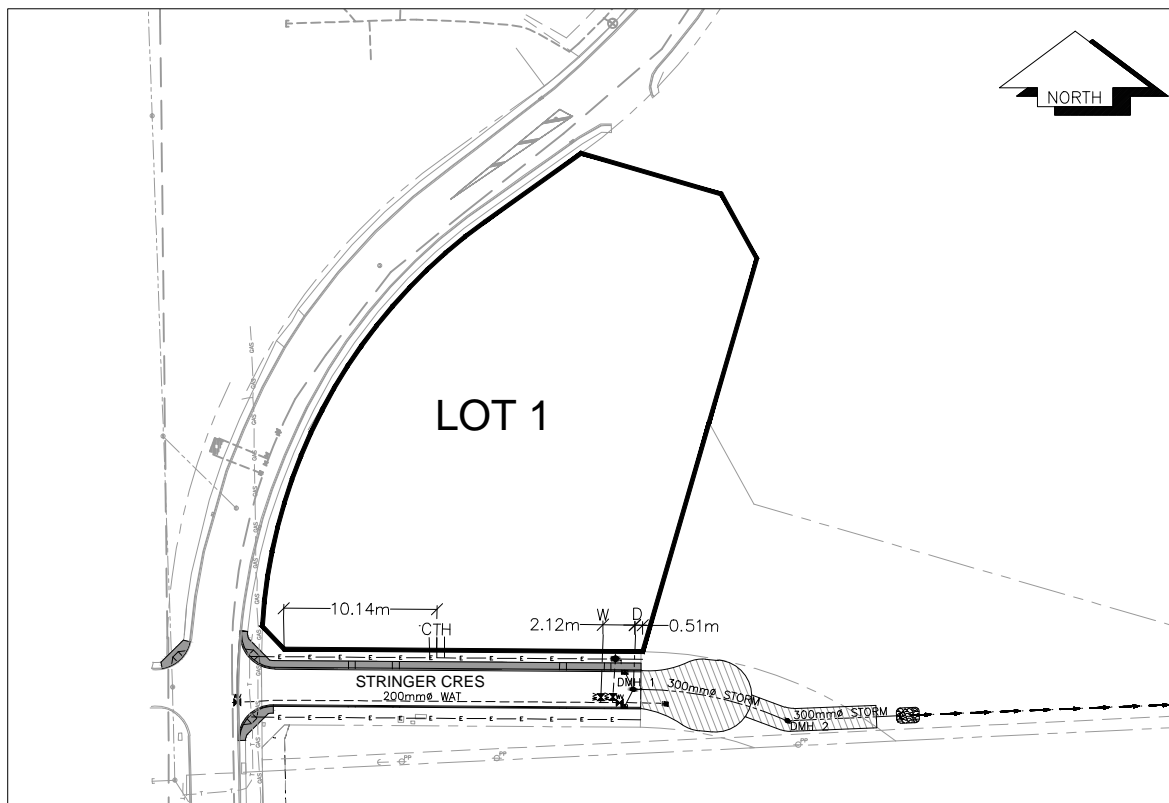

SANITARY, STORM & WATER SERVICE INVERTS	SANITARY	WATER	STORM
1. Distance from San. M.H. <u> N/A </u> toward San. M.H. <u> N/A </u> to lot service connection point is:	N/A	N/A	N/A
1a.Distance from Stm. M.H. <u> DMH 1 </u> toward Stm. M.H. <u> N/A </u> to lot service connection point is:	N/A	N/A	N/A
2. Main Size at connection point is	N/A	200mmØ	300mmØ
3. Invert of service at main conn. stub point is	N/A	648.71	648.77m
4. Invert at service end is	N/A	648.65	648.96m
5. Cover at property line in meters	N/A	3.07m	2.42m
6. Survey Date: OCT 2013 Book Ref.: 1390-01-04 By: L&M ENGINEERING LTD			

SANITARY HISTORY:

DATE INSTALLED: N/A

INSTALLED BY: N/A

WATER HISTORY:

DATE INSTALLED: AUGUST 2013

INSTALLED BY: CAPCO

STORM HISTORY:

DATE INSTALLED: AUGUST 2013

INSTALLED BY: CAPCO