



City of Prince George
History Sheet

PID:	027965791
SD/MU:	
WO:	

Civic Address: 2844 Bernard Rd

Legal Description: Lot: B District Lot: 754 Plan: BCP41536


Service Type	Diameter (mm)	Material	Invert Elev at main (m)	Invert Elev at property line (m)	Invert Elev at service end (m)	Distance into property (m)	Installation Date
Sanitary	100mm	PVC	-	-	-	-	-
Water	13mm	Copper	-	-	-	-	-
Storm	100mm	PVC	-	-	-	-	-

Service Connection Location	Sanitary (m)	Storm (m)
Sanitary sewer service connected to SMH4250	-	
Storm sewer service connected to DMH486		

Power	Size	Communications	Size	Cable	Size	Gas	Size
BC Hydro	-	Telus	-	Shaw	-	FortisBC	-
Overhead Service		Overhead Service		Overhead Service			

Installed by:	Survey Date:	-
Comments: Water service location confirmed May 2014		

NOT TO SCALE The information contained herein is for internal use only.
Not to be relied on unless confirmed by site inspection and/or investigation.

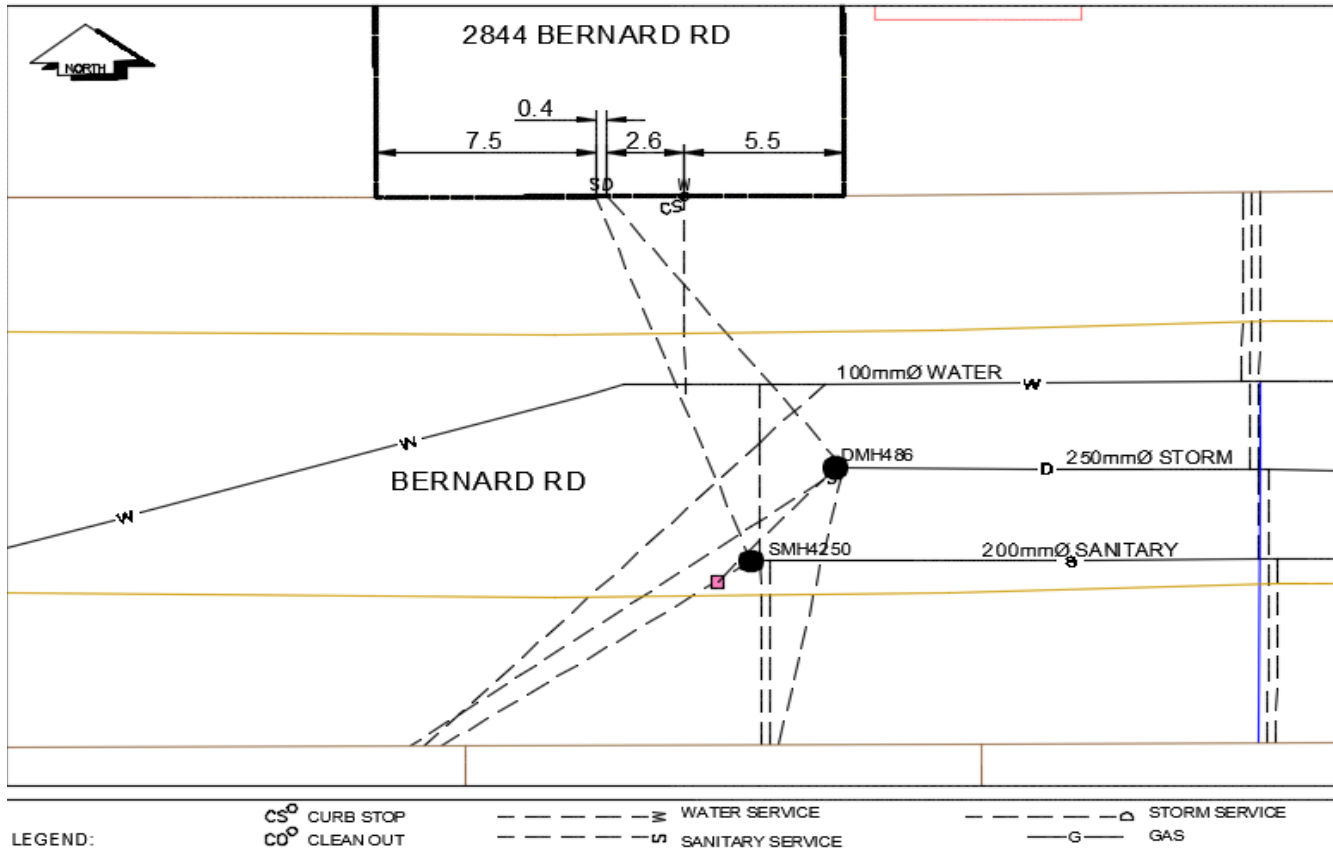

NOT TO SCALE