

City of Prince George
HISTORY SHEET

P.I.D. 027983579

Legal: LOT 3

D.L. 747

PLAN BCP41328

Address: 4620 PACIFIC STREET

Sanitary Connection: SIZE: N/A MATERIAL: N/A INV. N/A CONNECTED

Water Connection: SIZE: N/A MATERIAL: N/A INV. N/A METER

Storm Connection: SIZE: MATERIAL: INV. CONNECTED

Cash Receipt No's: WATER SANITARY STORM

CURB FROM PROPERTY LINE 6.8m PAVEMENT WIDTH 10.5m

B.C. HYDRO O.H. U/G CONNECTION

B.C. TELEPHONE U/G U/G CONNECTION ✓


B.C. GAS 168DP

SCALE: 1:2000

Information Sheets: INFORMATION FOR WATER AND SANITARY TAKEN FROM PREVIOUS CoPG HISTORY SHEET
REF. DWGS. L&M ENGINEERING LTD. JOB. 1126-13-3.4 DWGS.(001-501)

Comments: C.S. CURB STOP --- W WATER SERVICE --- H HYDRO SERVICE --- GAS GAS
C.O. CLEAN OUT --- S STORM SERVICE --- C CABLE SERVICE --- E ELECTRICAL
SANITARY SERVICE TELECOMMUNICATIONS

THE INFORMATION CONTAINED HEREIN IS FOR INTERNAL USE ONLY.
NOT TO BE RELIED UPON UNLESS CONFIRMED BY THE SITE INSPECTION AND/OR INVESTIGATION

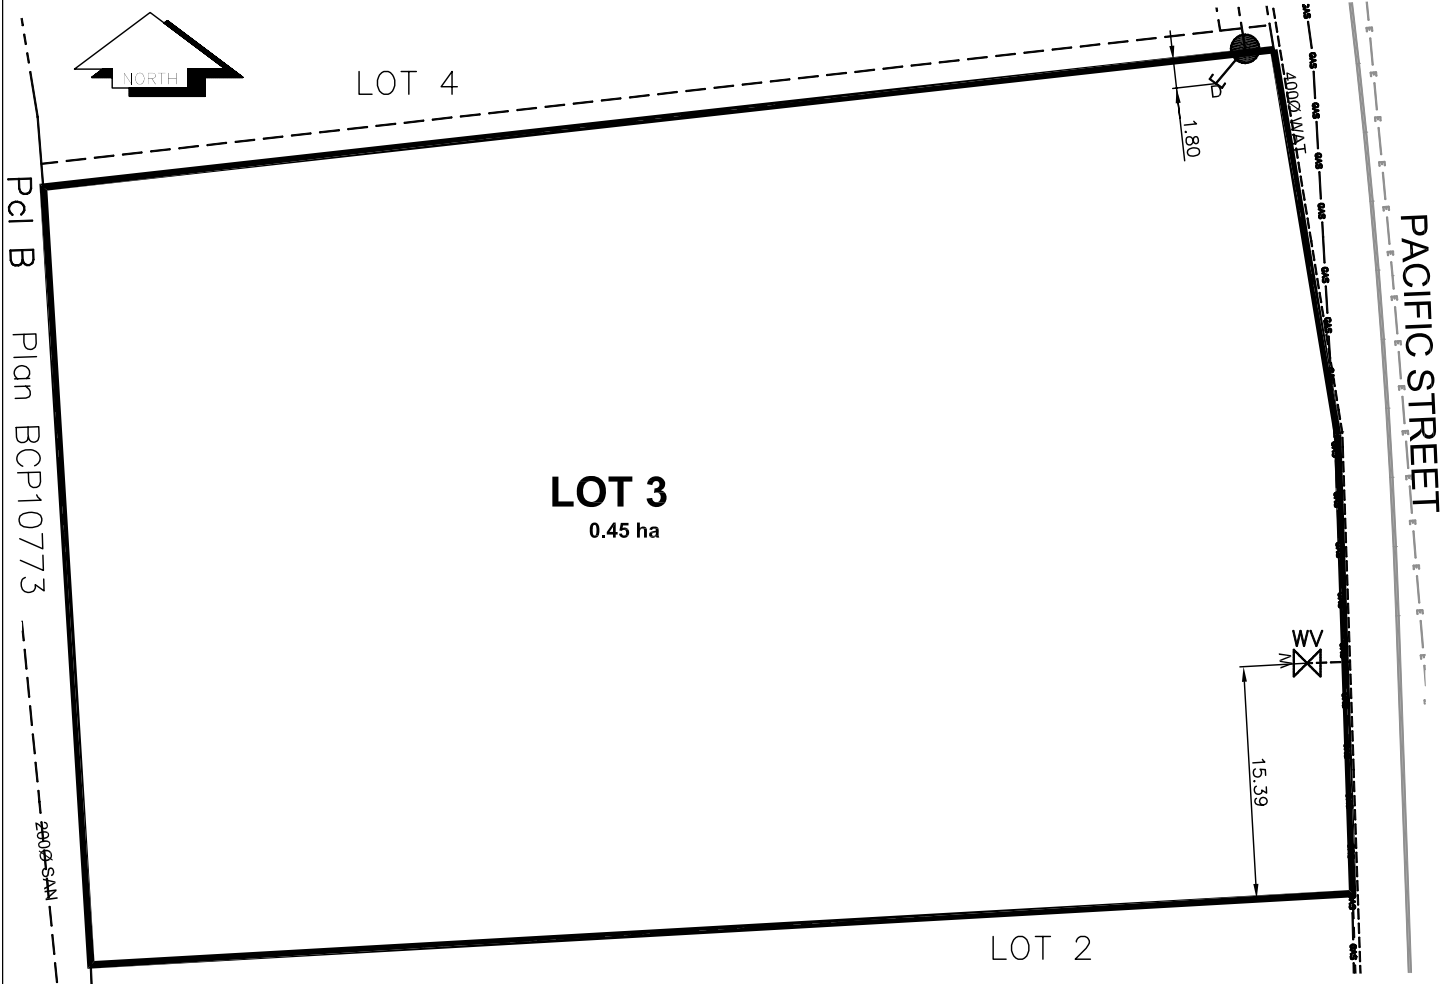

SANITARY, WATER & STORM SERVICE INVERTS	SANITARY	WATER	STORM
1. Distance from San. M.H. to connection point is toward San. M.H.	N/A	N/A	N/A
1a.Distance from Stm. M.H. to connection point is toward Stm. M.H.	N/A	N/A	N/A
2. Main Size at connection point is	N/A	N/A	N/A
3. Invert of main at conn. stub pt is	N/A	N/A	N/A
4. Invert at service end is	N/A	N/A	N/A
5. Cut at P/I in meters	N/A	N/A	N/A
6. Survey Date: SEPTEMBER 2006 Book Ref. 1126-13-3.4 by ALLNORTH			

SANITARY HISTORY:

WATER HISTORY:

STORM HISTORY:
