

City of Prince George

HISTORY SHEET

P.I.D. 027983587

Legal: LOT 4

D.L. 747

PLAN BCP 41328

Address: PACIFIC STREET 2912 PACIFIC STREET

Sanitary Connection: SIZE: N/A MATERIAL: N/A INV. N/A CONNECTED

Water Connection: SIZE: N/A MATERIAL: N/A INV. N/A METER

Storm Connection: SIZE: 450mmØ MATERIAL: PVC INV. 590.63 CONNECTED

Cash Receipt No's: WATER SANITARY STORM

CURB FROM PROPERTY LINE 6.8m PAVEMENT WIDTH 10.5m

B.C. HYDRO O.H. U/G CONNECTION

B.C. TELEPHONE U/G U/G CONNECTION


B.C. GAS 168DP

SCALE: 1:3000

Information Sheets: INFORMATION FOR WATER AND SANITARY TAKEN FROM PREVIOUS CoPG HISTORY SHEET
REF. DWGS. L&M ENGINEERING LTD. JOB. 1126-13-3.4 DWGS.(001-501)

Comments: C.S. CURB STOP --- S.W. WATER SERVICE --- H. HYDRO SERVICE
C.O. CLEAN OUT --- S. STORM SERVICE --- C. CABLE SERVICE
--- E. ELECTRICAL

THE INFORMATION CONTAINED HEREIN IS FOR INTERNAL USE ONLY.
NOT TO BE RELIED UPON UNLESS CONFIRMED BY THE SITE INSPECTION AND/OR INVESTIGATION

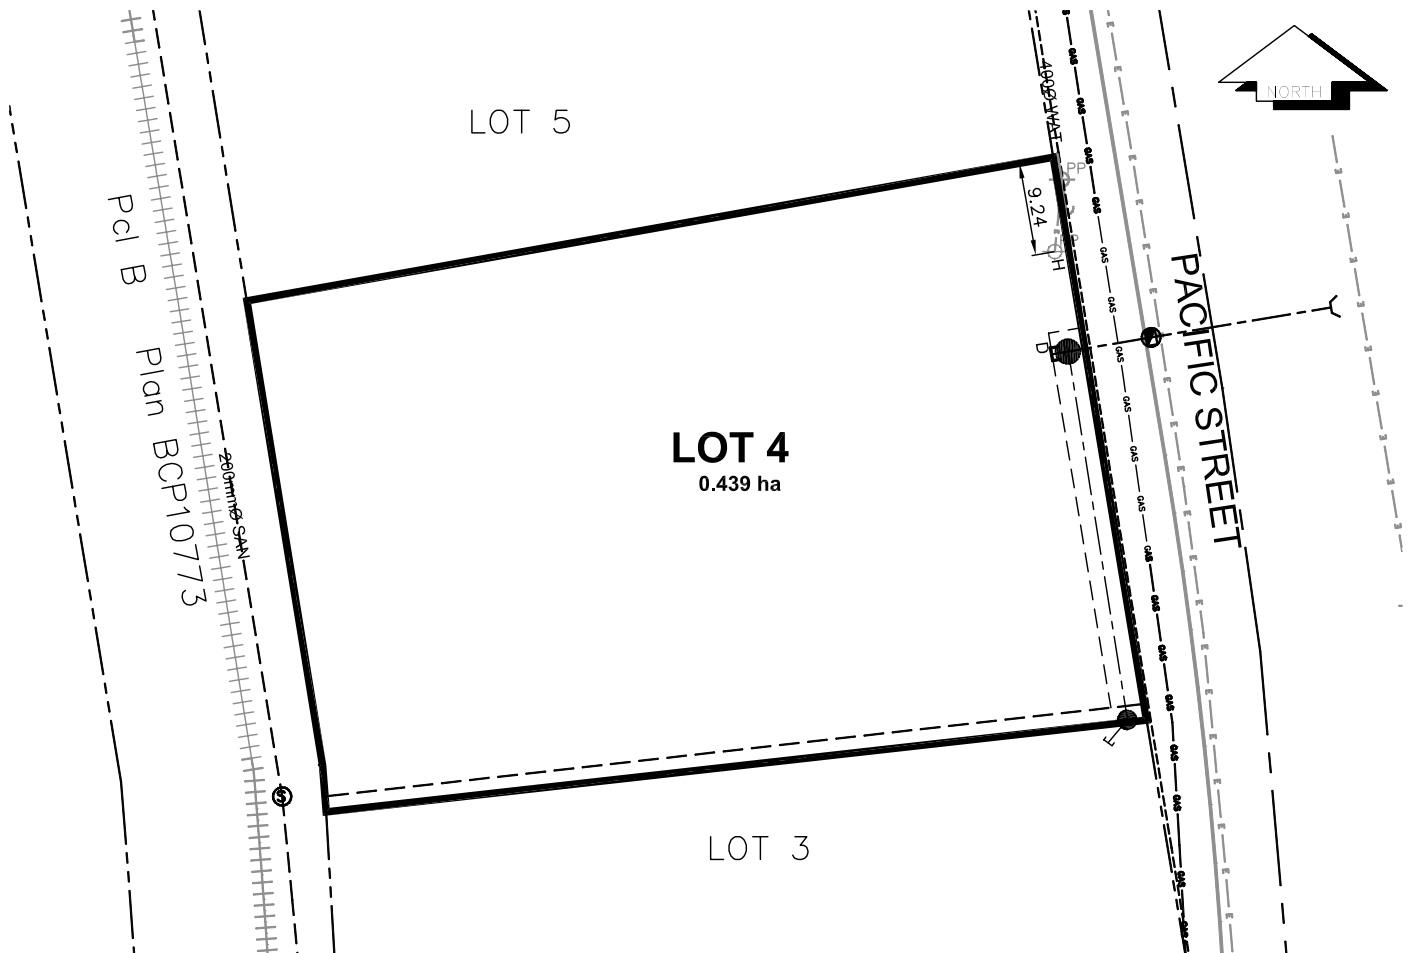

STORM

N/A

N/A

450mmØ

654.83

655.16

1.4m

WATER HISTORY:

STORM HISTORY: