

City of Prince George

HISTORY SHEET

P.I.D. 027983595

Legal: LOT 5

D.L. 747

PLAN BCP 41328

Address: 1204 PACIFIC STREET

Sanitary Connection: SIZE: 200mmØ MATERIAL: INV. CONNECTED

Water Connection: SIZE: 400mmØ MATERIAL: INV. METER

Storm Connection: SIZE: 450mmØ MATERIAL: PVC INV. 589.61m CONNECTED

Cash Receipt No's: WATER SANITARY STORM

CURB FROM PROPERTY LINE 6.8m PAVEMENT WIDTH 10.5m

B.C. HYDRO O.H. U/G CONNECTION

B.C. TELEPHONE U/G U/G CONNECTION ✓


B.C. GAS 168DP

SCALE: 1:5000

INFORMATION FOR WATER AND SANITARY TAKEN FROM PREVIOUS CoPG HISTORY SHEET
Information Sheets: REF. DWGS. L&M ENGINEERING LTD. JOB. 1126-13-3.4 DWGS.(001-501)

Comments: C.S. CURB STOP --- W.S. WATER SERVICE --- H.C. HYDRO SERVICE --- GAS --- GAS
C.O. CLEAN OUT --- S.S. STORM SERVICE --- C.S. CABLE SERVICE --- E --- ELECTRICAL
S.S. SANITARY SERVICE --- T.C. TELECOMMUNICATIONS

THE INFORMATION CONTAINED HEREIN IS FOR INTERNAL USE ONLY.
NOT TO BE RELIED UPON UNLESS CONFIRMED BY THE SITE INSPECTION AND/OR INVESTIGATION

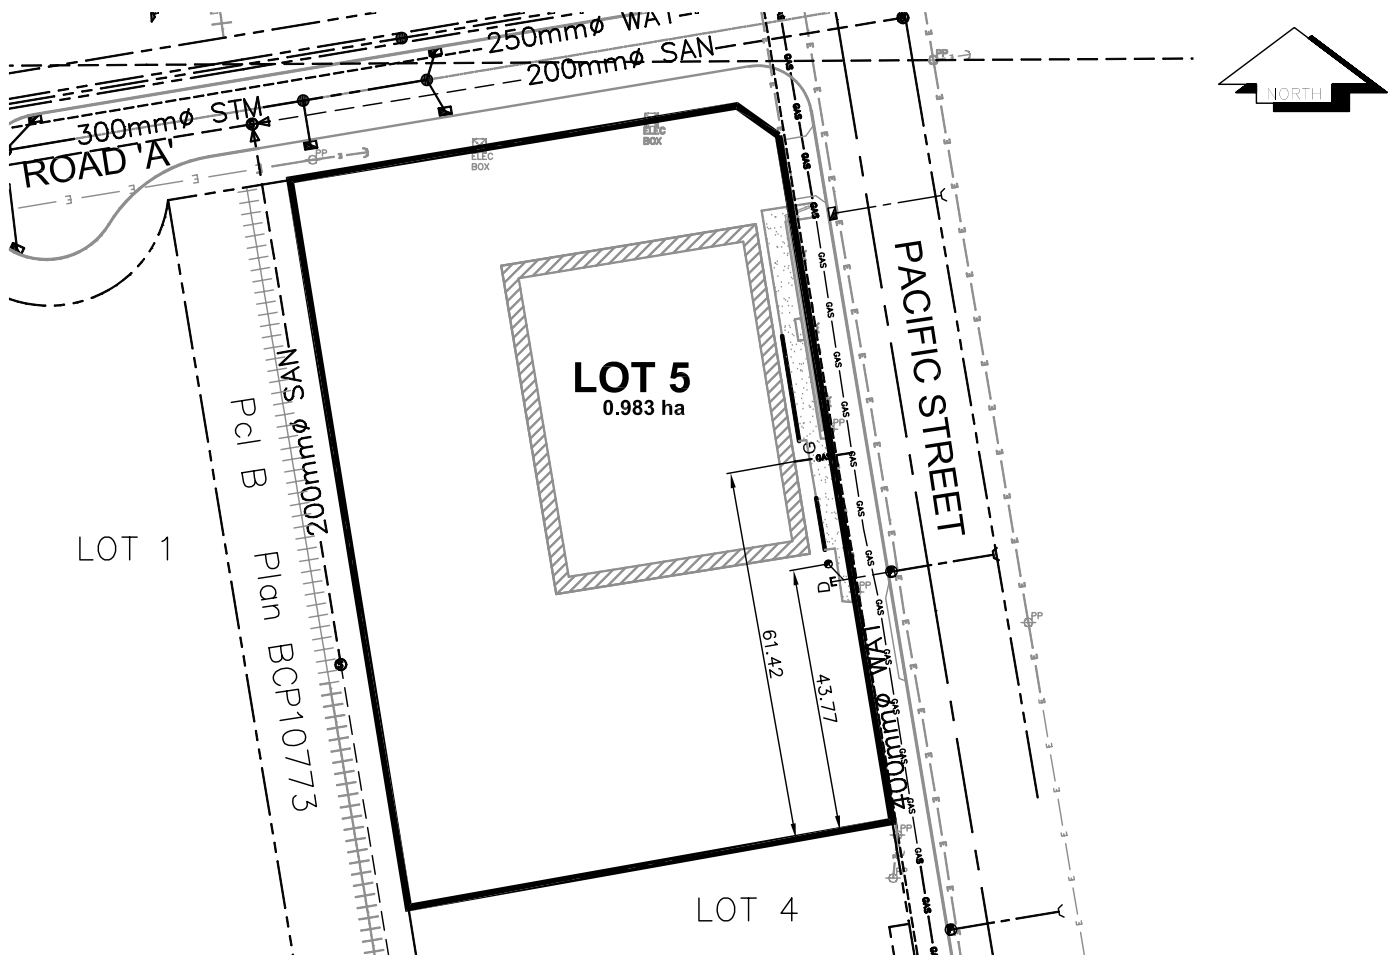

STORM

N/A

N/A

450mmØ

589.51

589.61

STORM HISTORY: