


Lot Servicing

4382 5TH AVE

PID: 027986551

Lot: **B**, Plan: **BCP41838**, DL: **2507**

SERVICE	SIZE	MATERIAL	INSTALLED DATE	LOCATION	DETAILS
				NO SERVICE	
				NO SERVICE	

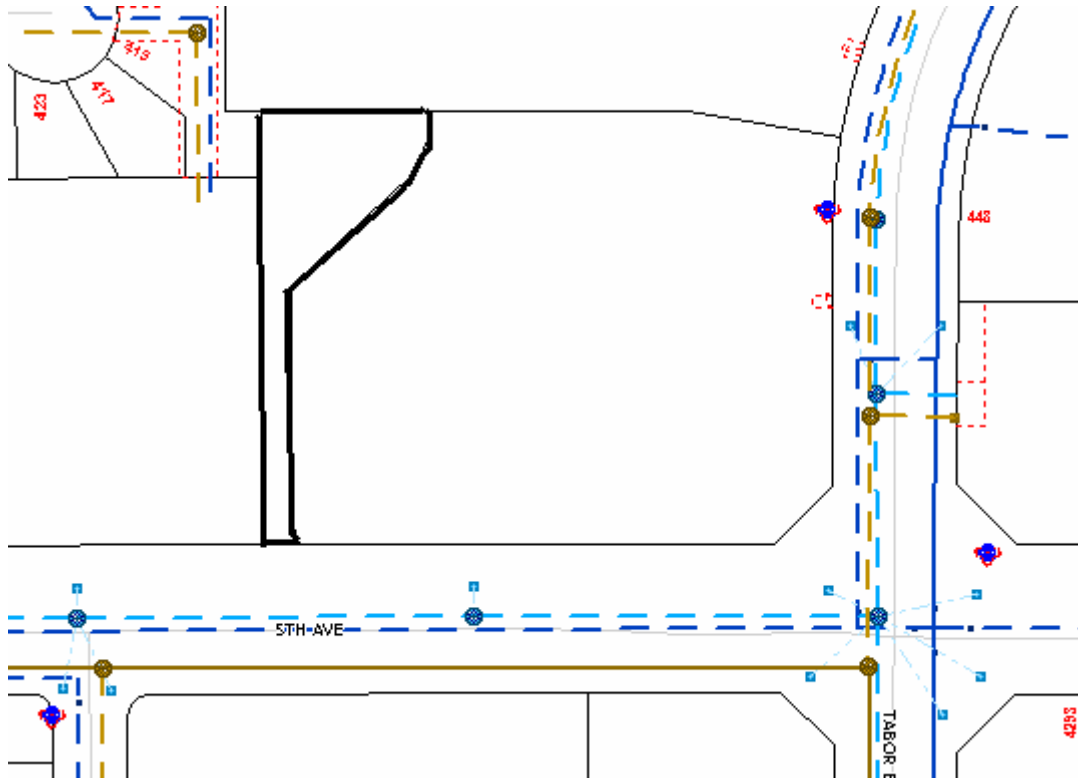

Accuracy not guaranteed unless confirmed by site inspection and/or investigation.
Connection location between main and property line only.