


Lot Servicing

3862 RUSTAD RD

PID: 027990834

Lot: **A**, Plan: **BCP41860**, DL: **4376**

SERVICE	SIZE	MATERIAL	INSTALLED DATE	LOCATION	DETAILS
SANITARY	100MM	PVC	22-Sep-1993	8.9M S OF N PL	ELEV OF INVERT @ P/L 596.14

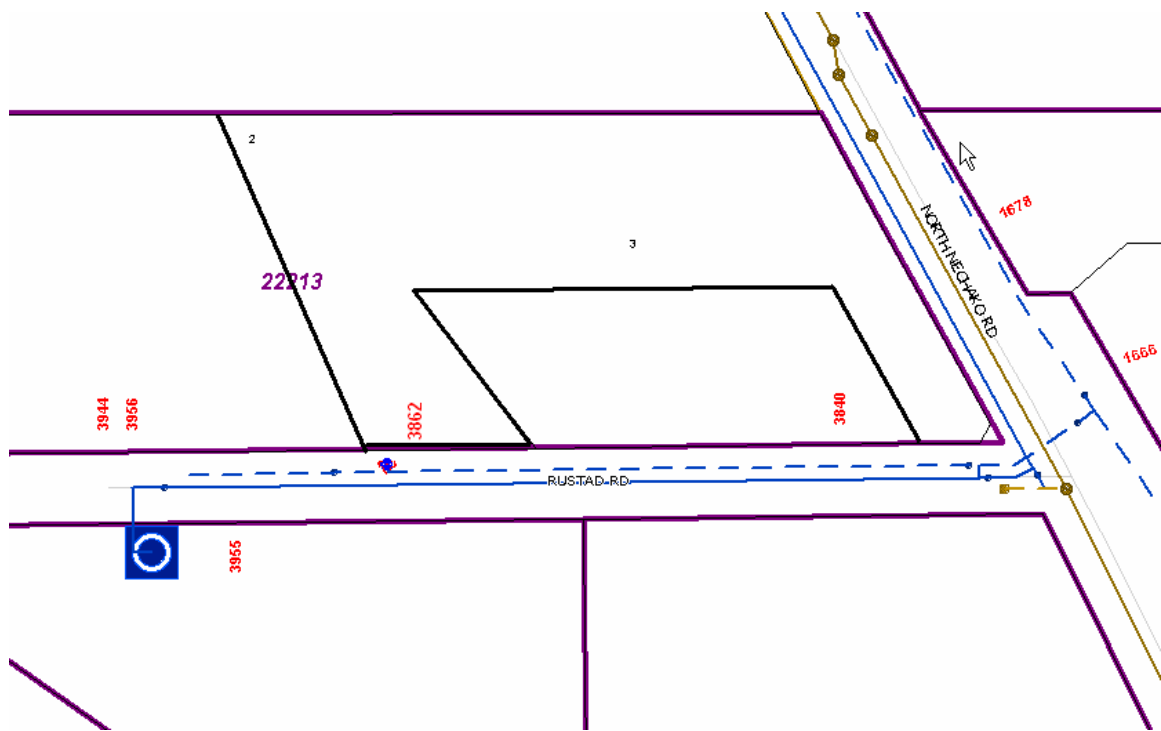

Accuracy not guaranteed unless confirmed by site inspection and/or investigation.
Connection location between main and property line only.