


## Lot Servicing

905 BURDEN ST

PID: 027997596

**Lot:** PCL A, **Block:** 81, **Plan:** 1268, **DL:** 343

SERVICE	SIZE	MATERIAL	INSTALLED DATE	LOCATION	DETAILS
WATER	20MM	CU	01-Jan-1975	FR SE COR BLD 13.106M E 3.657M S	CONNECTION NUMBER 10079
SANITARY	UNKNOWN	UNKNOWN		NO LOCATION	CONNECTION # 2200

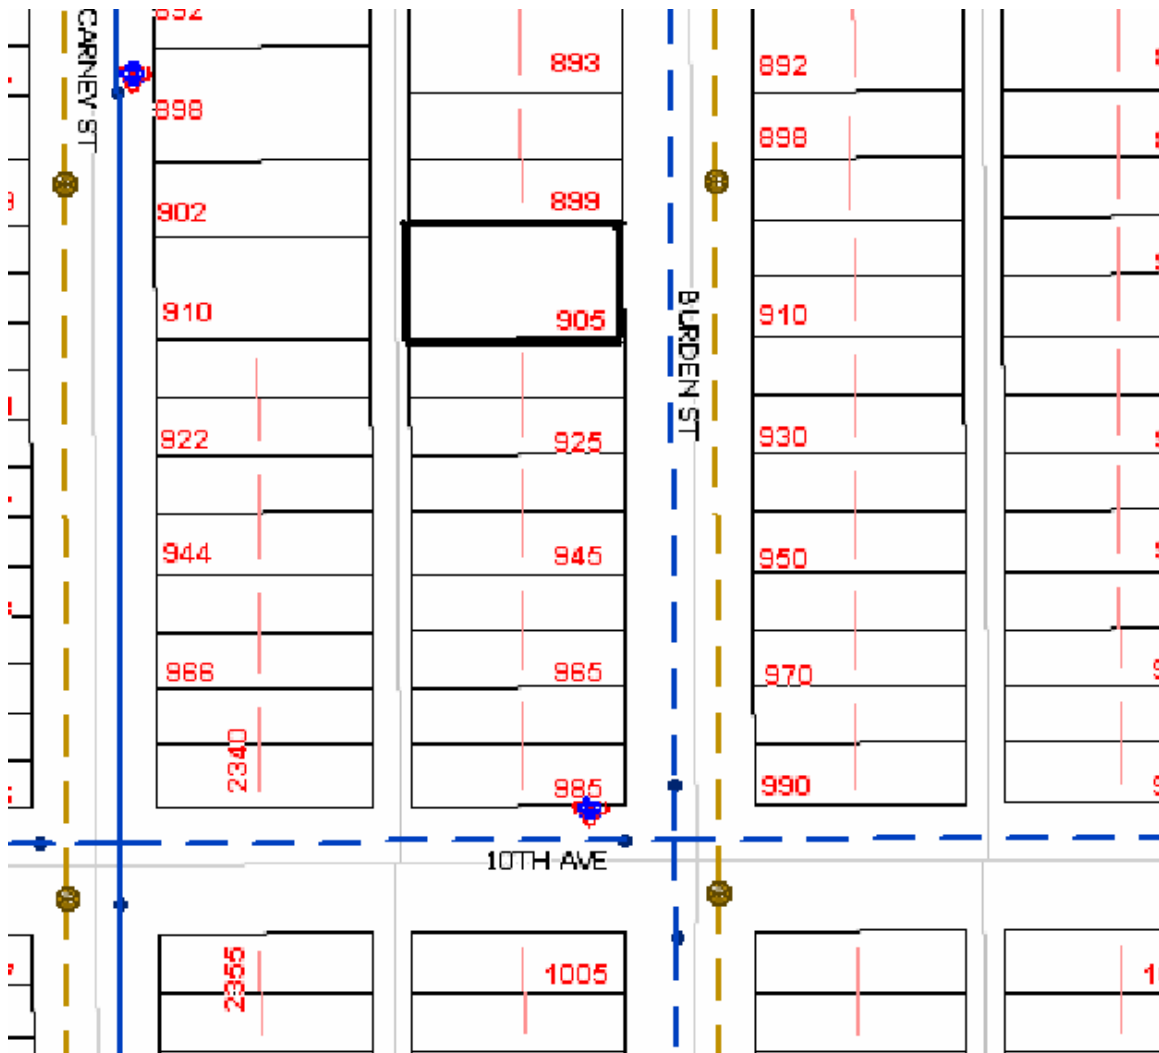

Accuracy not guaranteed unless confirmed by site inspection and/or investigation.  
Connection location between main and property line only.