


Lot Servicing

679 15TH AVE

PID: 028004213

Lot: PCL 1, **Block:** 242, **Plan:** 1268, **DL:** 343

SERVICE	SIZE	MATERIAL	INSTALLED DATE	LOCATION	DETAILS
WATER	20MM	CU		8.3M N OF S PL	THAW WIRE Y
SANITARY	UNKNOWN	UNKNOWN		9.449M S OF NW PL	ELEV OF INVERT @ P/L 575.8

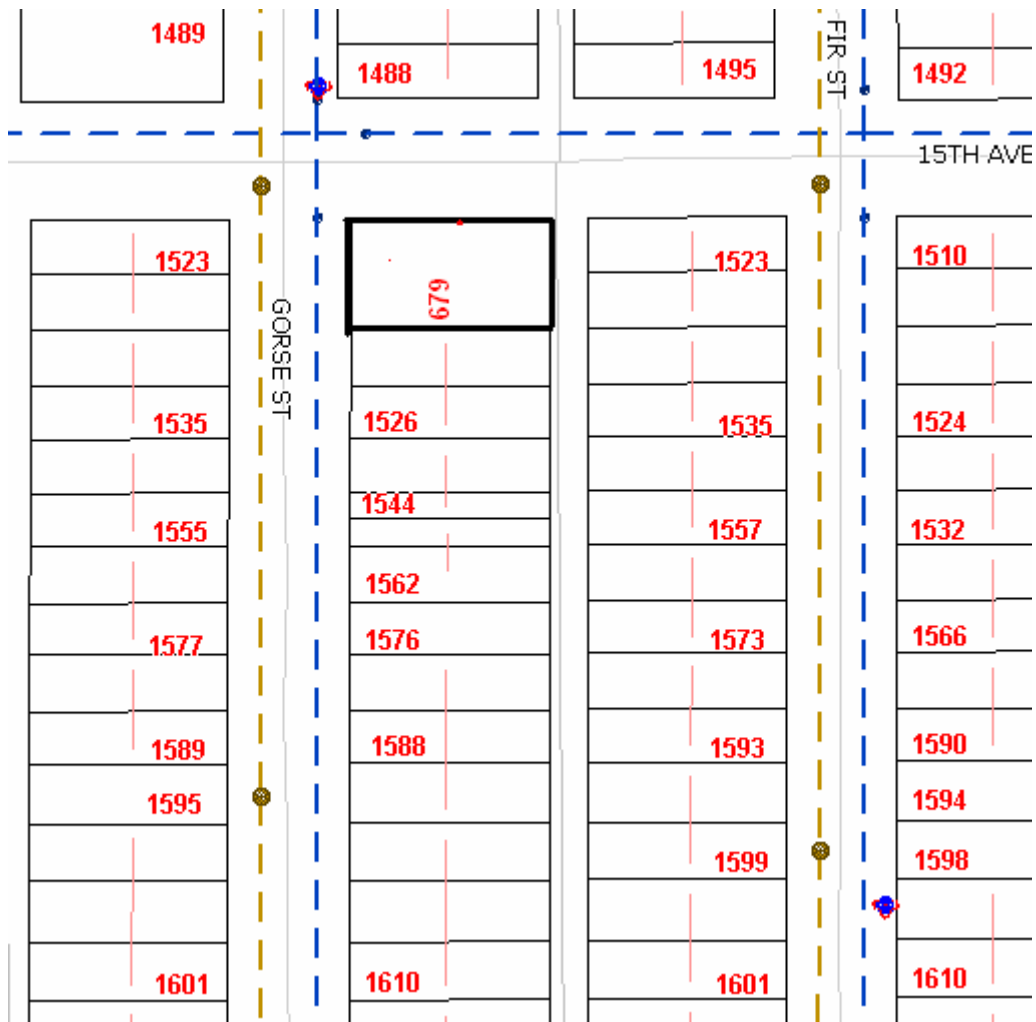

Accuracy not guaranteed unless confirmed by site inspection and/or investigation.
Connection location between main and property line only.