



CITY OF  
PRINCE GEORGE

# City of Prince George HISTORY SHEET

PID:	031-946-585
SD/MU:	MU102638
WO:	

CIVIC ADDRESS: 8875 WILLOWCALE ROAD

LEGAL DESCRIPTION: LOT 2 DL 749


PLAN BCP41575

SERVICE TYPE	DIAMETER (mm)	MATERIAL	INVERT ELEV AT MAIN (m)	INVERT ELEV AT PROPERTY LINE (m)	INVERT ELEV AT SERVICE END (m)	COVER AT PROPERTY LINE (m)	DISTANCE INTO PROPERTY (m)	INSTALLATION DATE
SANITARY	N/A	N/A	N/A	N/A	N/A	N/A	N/A	N/A
WATER	200	PVC	579.82	579.72	579.69	2.58	3.0	JUNE 2023
STORM	N/A	N/A	N/A	N/A	N/A	N/A	N/A	N/A

ELECTRICAL / COMMUNICATIONS / GAS			
TYPE	PROVIDER	SIZE AND MATERIAL	LOCATION ( UNDERGROUND/ OVERHEAD)
ELECTRICAL	BC HYDRO	N/A	UNDERGROUND
COMMUNICATION	TELUS	N/A	UNDERGROUND
COMMUNICATION	SHAW	N/A	UNDERGROUND
GAS	FORTISBC	N/A	UNDERGROUND

INFORMATION SHEETS: L&M ENGINEERING LIMITED PROJECT NUMBER 1145-32	SURVEY DATE:
INSTALLED BY: BRINK GROUP OF COMPANIES	
COMMENTS: WATER SERVICE IS INSULATED.	

THE INFORMATION CONTAINED HEREIN IS FOR INTERNAL USE ONLY.  
NOT TO BE RELIED UPON UNLESS CONFIRMED BY SITE INVESTIGATION.

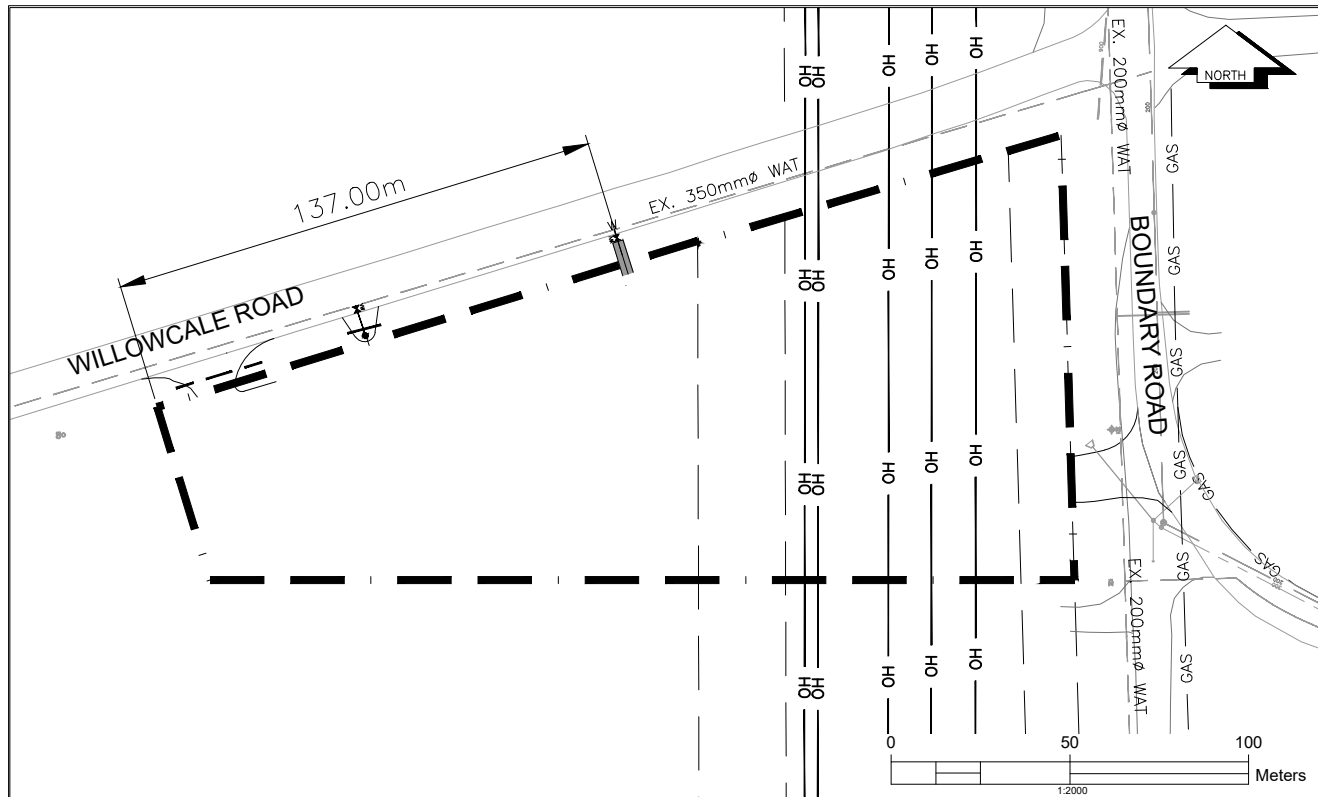

**LEGEND:**

WATER HYDRANT, LEAD & VALVE	WATER SERVICE	STORM SERVICE	SANITARY SERVICE	HYDRO SERVICE	TELECOMMUNICATIONS	GAS	SHALLOW UTILITIES
-----------------------------	---------------	---------------	------------------	---------------	--------------------	-----	-------------------