

City of Prince George

HISTORY SHEET

PID: ~~015-048-781~~ 028038908

Legal: LOT 4

D.L. - 749

PLAN - BCP 41575

Address: ⁸⁷⁸⁷ WILLOW CALE ROAD

SCALE: 1 : 2,500

Sanitary Connection:#	SIZE:	MATERIAL: -	INV.	CONNECTED
-----------------------	-------	-------------	------	-----------

Water Connection:#	SIZE: 50mmØ	MATERIAL: COPPER	INV. 578.78	METER
--------------------	-------------	------------------	-------------	-------

Storm Connection:#	SIZE	MATERIAL -	INV.	CONNECTED
--------------------	------	------------	------	-----------

Cash Receipt No's:	WATER	SANITARY	STORM
--------------------	-------	----------	-------

CURB FROM PROPERTY LINE	9m	PAVEMENT WIDTH	12m
-------------------------	----	----------------	-----

B.C. HYDRO	U/G CONNECTION
------------	----------------

B.C. TELEPHONE	U/G CONNECTION
----------------	----------------


B.C. GAS

Information Sheets: REF. DWGS. L&M ENGINEERING LTD. JOB. 1126-13-3.2 DWGS (001-308)

Comments:	CS CURB STOP	SDW	WATER SERVICE	HYDRO SERVICE	— GAS —	GAS
	CO CLEAN OUT		STORM SERVICE	CABLE SERVICE	— E —	ELECTRICAL
			SANITARY SERVICE	TELECOMMUNICATIONS		

THE INFORMATION CONTAINED HEREIN IS FOR INTERNAL USE ONLY.

NOT TO BE RELIED UPON UNLESS CONFIRMED BY THE SITE INSPECTION AND/OR INVESTIGATION

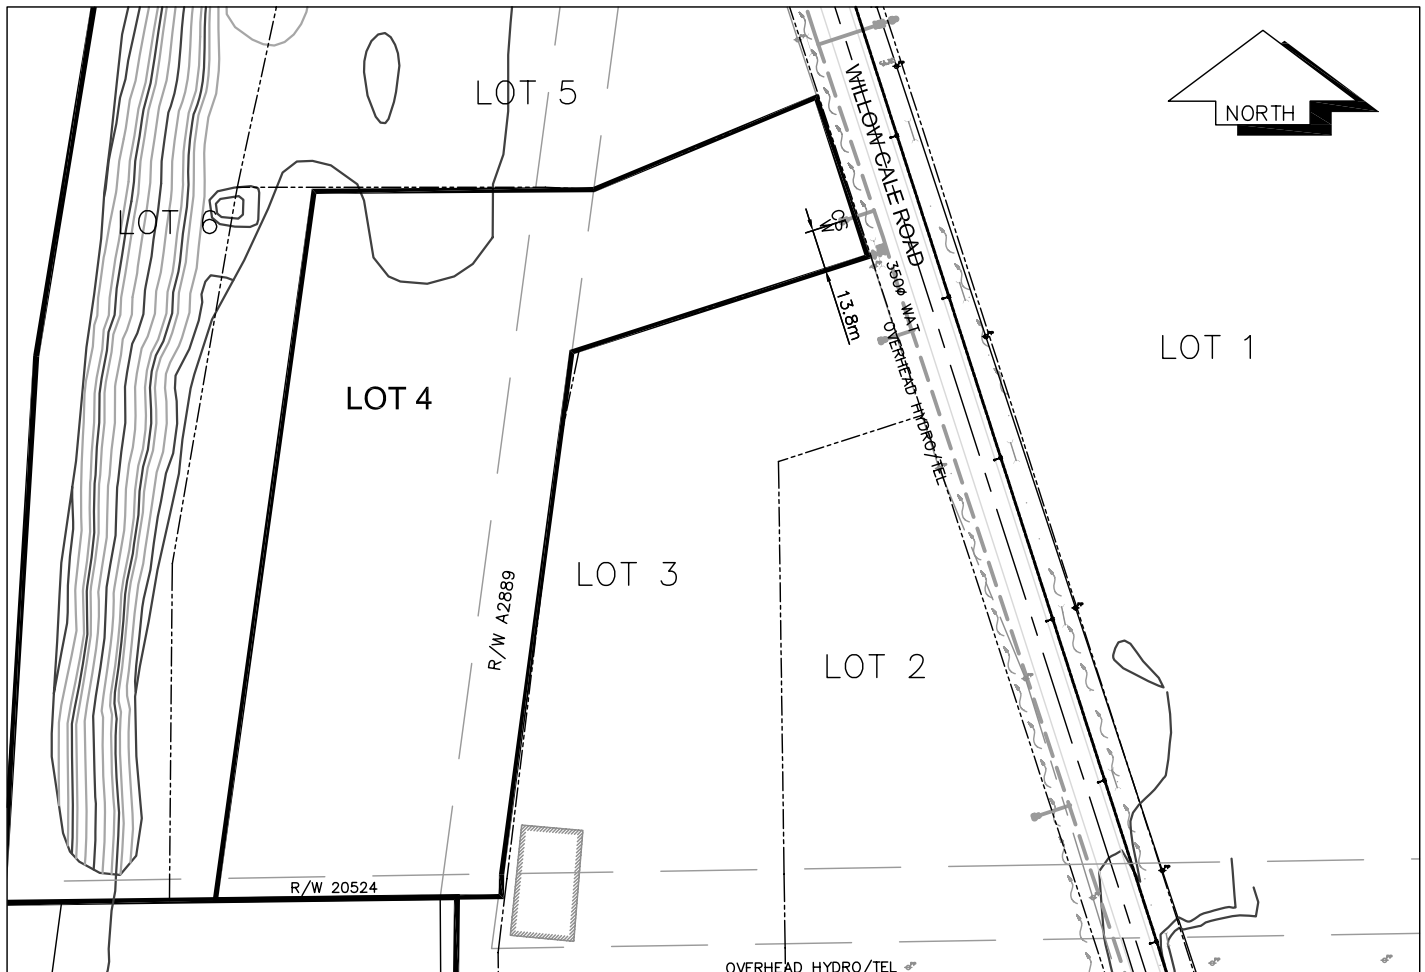

SANITARY, STORM & WATER SERVICE INVERTS	SANITARY	WATER	STORM
1. Distance from San. M.H. toward San. M.H. to lot service connection point is:	N/A	-m	N/A
1a.Distance from Stm. M.H. toward Stm. M.H. to lot service connection point is:	N/A	-m	N/A
2. Main Size at connection point is	N/A	350mmØ	N/A
3. Invert of main at conn. stub pt is	N/A	579.78m	N/A
4. Invert at service end is	N/A	578.78m	N/A
5. Cut at P/I in meters	N/A	3.04m	N/A
6. Survey Date: JULY 06 Book Ref.: 1126-13-3.2 By: Allnorth Engineering			

SANITARY HISTORY:

WATER HISTORY:

Water service is insulated with Hi-40 styrofoam insulation 50mm thickness at ditch crossing

STORM HISTORY:
