
City of Prince George

HISTORY SHEET

PID: 615=048<i>-</i>78 ‡	028038916							
egal: LOT 5				D.L		PLAN - BCP41575		
8715 Address: WILLOV	V CALE ROAD			SCALE: 1:1,500				
Sanitary Connection:	\$ SIZE:		MATERIAL:	-	INV.	CONNECTED		
Water Connection:#	SIZE:	50mmØ	MATERIAL:	COPPER	INV. 5	578.69 METER		
Storm Connection:#	SIZE		MATERIAL	-	INV.	CONNECTED		
Cash Receipt No's:		WATER		SANITARY		STORM		
CURB FROM PROPERTY LIN	NE 9m					PAVEMENT WIDTH 12m		
B.C. HYDRO		U/G CONNECTION						
B.C. TELEPHONE	U/G CONNECTION							
B.C. GAS								
Information Sheets: REF. DWGS. L&M ENGINEERING LTD. JOB. 1126-13-3.2 DWGS (001-308)								
Comments:	CS CURB STOP CO CLEAN OUT	 	WATER SERVIC STORM SERVIC SANITARY SER	E E VICE	HYDRO CABLE S	SERVICE — GAS — GAS SERVICE — ELECTRICAL		

THE INFORMATION CONTAINED HEREIN IS FOR INTERNAL USE ONLY.

NOT TO BE RELIED UPON UNLESS CONFIRMED BY THE SITE INSPECTION AND/OR INVESTIGATION

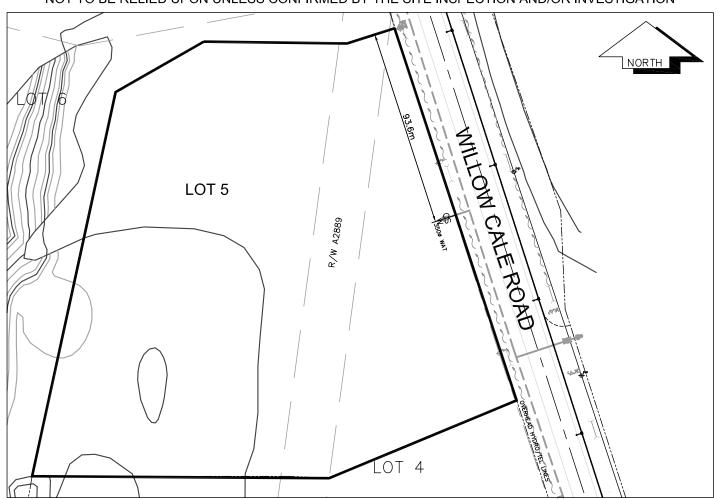

SANITARY, STORM & WATER SERVICE INVERTS	SANITARY	WATER	STORM
1. Distance from San. M.H. toward San. M.H. to lot service connection point is:	N/A	N/A	N/A
1a.Distance from Stm. M.H. toward Stm. M.H. to lot service connection point is:	N/A	N/A	N/A
2. Main Size at connection point is	N/A	350mmØ	N/A
3. Invert of main at conn. stub pt is	N/A	578.87m	N/A
4. Invert at service end is	N/A	578.69m	N/A
5. Cut at P/I in meters	N/A	2.34m	N/A
6. Survey Date: JULY 06 Book Ref.: 1126-13-3.2 By: Allnorth Engineering			
SANITARY HISTORY:			
WATER HISTORY:			
-			
STORM HISTORY:			