

City of Prince George

HISTORY SHEET

PID: ~~015-048-781~~ 028038924

Legal: LOT 6

D.L. - 749

PLAN - BCP 41575

8669

Address: WILLOW CALE ROAD

SCALE: 1 : 7,500

Sanitary Connection:# SIZE: MATERIAL: - INV. CONNECTED

Water Connection:# SIZE: 350mmØ MATERIAL: - INV. - METER

Storm Connection:# SIZE MATERIAL: - INV. CONNECTED

Cash Receipt No's: WATER SANITARY STORM

CURB FROM PROPERTY LINE 9m PAVEMENT WIDTH 12m

B.C. HYDRO U/G CONNECTION

B.C. TELEPHONE U/G CONNECTION


B.C. GAS

Information Sheets: REF. DWGS. L&M ENGINEERING LTD. JOB. 1126-13-3.2 DWGS (001-308)

Comments: CS CURB STOP SDW WATER SERVICE HYDRO SERVICE GAS GAS
CO CLEAN OUT SDW STORM SERVICE CABLE SERVICE
SDW SANITARY SERVICE TELECOMMUNICATIONS E ELECTRICAL

THE INFORMATION CONTAINED HEREIN IS FOR INTERNAL USE ONLY.

NOT TO BE RELIED UPON UNLESS CONFIRMED BY THE SITE INSPECTION AND/OR INVESTIGATION

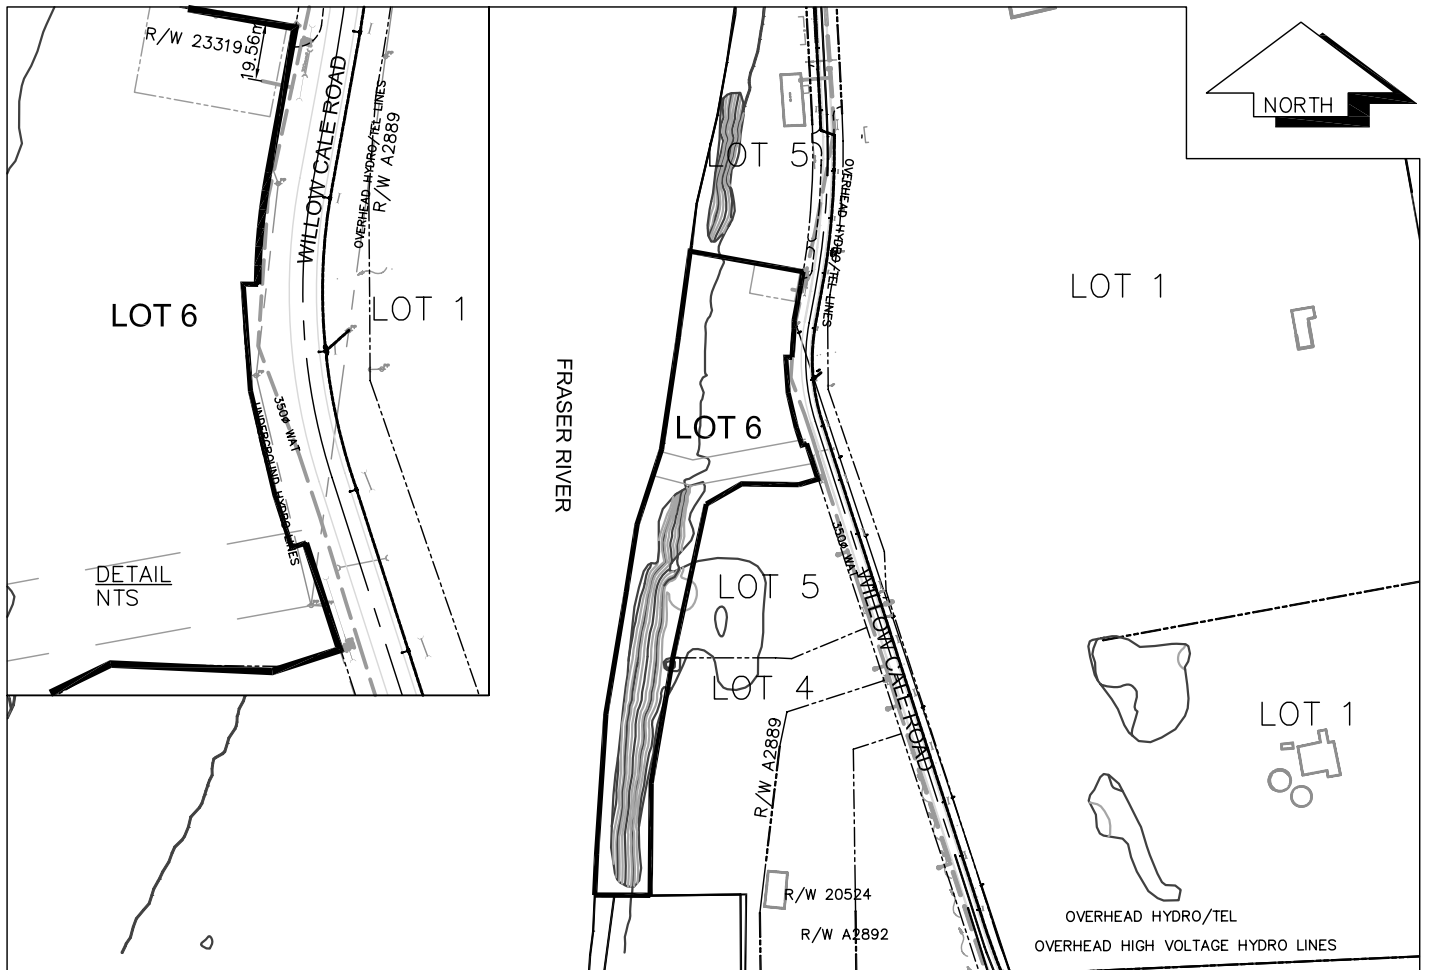

| SANITARY, STORM & WATER SERVICE INVERTS | SANITARY | WATER | STORM |
|---|----------|--------|-------|
| 1. Distance from San. M.H. toward San. M.H. to lot service connection point is: | N/A | N/A | N/A |
| 1a.Distance from Stm. M.H. toward Stm. M.H. to lot service connection point is: | N/A | N/A | N/A |
| 2. Main Size at connection point is | N/A | 350mmØ | N/A |
| 3. Invert of main at conn. stub pt is | N/A | N/A | N/A |
| 4. Invert at service end is | N/A | -m | N/A |
| 5. Cut at P/I in meters | N/A | -m | N/A |
| 6. Survey Date: JULY 06 Book Ref.: 1126-13-3.2 By: Allnorth Engineering | | | |
| | | | |
| | | | |
SANITARY HISTORY:

WATER HISTORY:

STORM HISTORY:
