


Lot Servicing

325 15TH AVE

PID: 028045025

Lot: PCL C, **Block:** 245, **Plan:** 1268, **DL:** 343 (BB1213092)

SERVICE	SIZE	MATERIAL	INSTALLED DATE	LOCATION	DETAILS
WATER	20MM	UNKNOWN		FR NW COR BLD 6.9M N 8.0M E	CONNECTION NUMBER 1932
SANITARY	100MM	AC		16.764M S OF SAN MH # 393811	CONNECTION # 4381

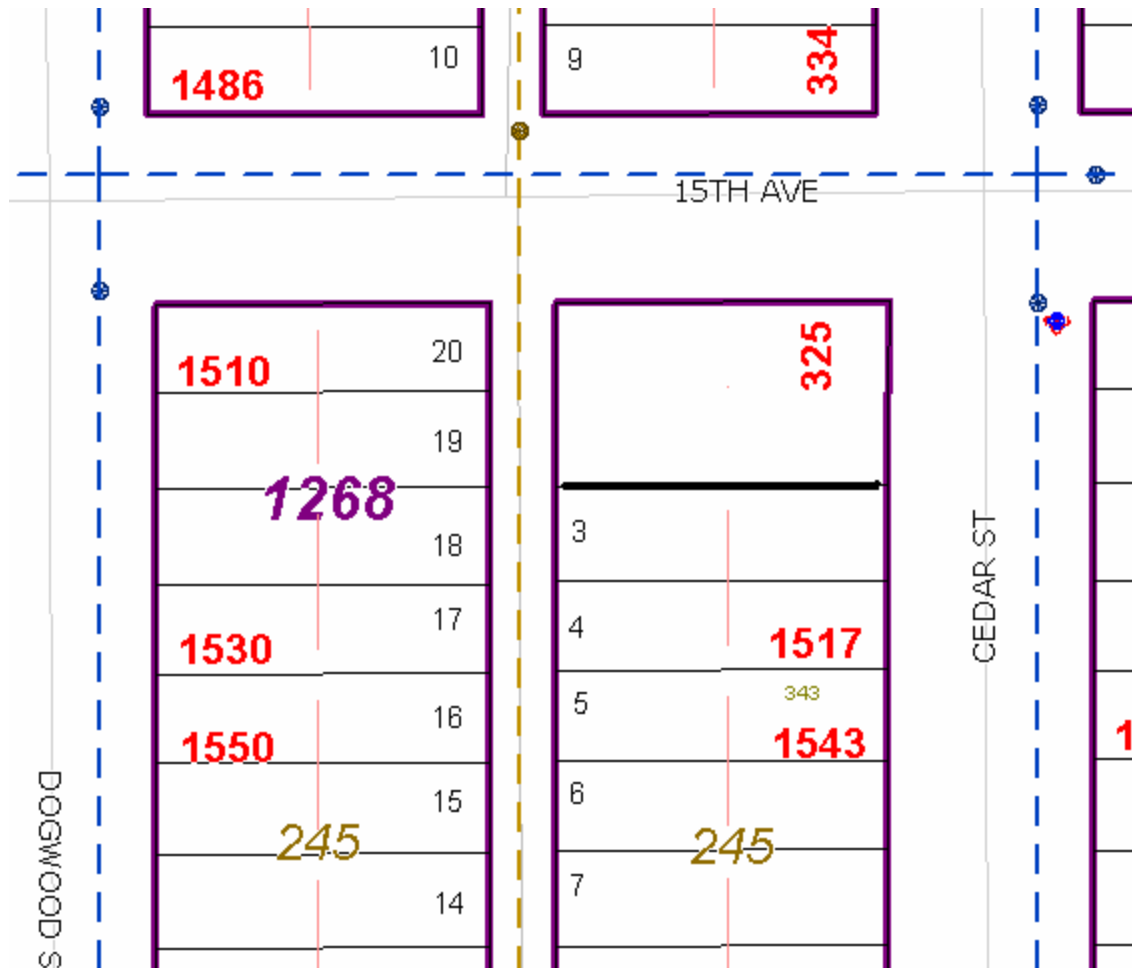

Accuracy not guaranteed unless confirmed by site inspection and/or investigation.
Connection location between main and property line only.