

City of Prince George

HISTORY SHEET

P.I.D. 028078098

Legal: LOT 1

D.L. 745

PLAN BCP 42634

Address: 1148 PACIFIC STREET

Sanitary Connection: SIZE: 150mmØ MATERIAL: PVC INV. 653.58m CONNECTED

Water Connection: SIZE: 100mmØ MATERIAL: N/A INV. 655.63m METER

Storm Connection: SIZE: 100mmØ MATERIAL: PVC INV. 655.16m CONNECTED

Cash Receipt No's: WATER SANITARY STORM

CURB FROM PROPERTY LINE 5.0m PAVEMENT WIDTH 10.0m

B.C. HYDRO 75mm DB2 U/G CONNECTION ✓

B.C. TELEPHONE 50mm DB2 U/G CONNECTION ✓

B.C. GAS 168DP


42 PROP/P.E.

SCALE: 1:6000

INFORMATION FOR WATER AND SANITARY TAKEN FROM PREVIOUS CoPG HISTORY SHEET
Information Sheets: REF. DWGS. L&M ENGINEERING LTD. JOB. 1126-13-3.4 DWGS.(001-501)

Comments: C.S. CURB STOP S.D.W. WATER SERVICE H.C. HYDRO SERVICE
C.C.O. CLEAN OUT S.D.S. STORM SERVICE C.C.S. CABLE SERVICE
S.S. SANITARY SERVICE T.C. TELECOMMUNICATIONS
GAS GAS
E ELECTRICAL

THE INFORMATION CONTAINED HEREIN IS FOR INTERNAL USE ONLY.
NOT TO BE RELIED UPON UNLESS CONFIRMED BY THE SITE INSPECTION AND/OR INVESTIGATION

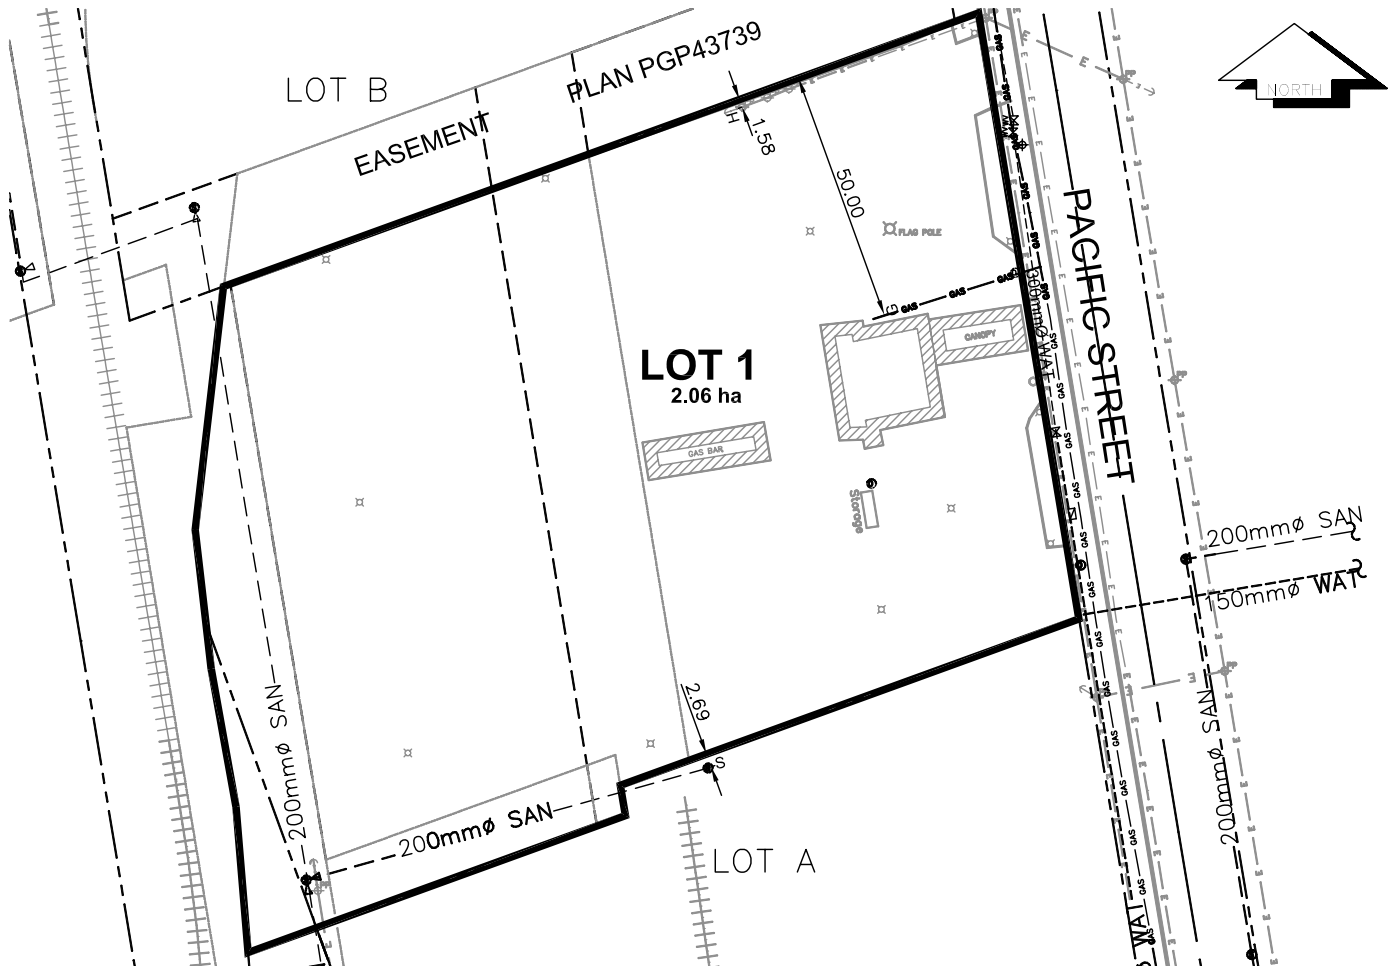

STORM

N/A

N/A

450mmØ

654.83

655.16

2.5m

[illegible][illegible][illegible][illegible]