
## City of Prince George HISTORY SHEET

PID: <b>028110200</b>						Scale:	1:500			
Legal: LOT 16						D.L.:	1600		PLAN:	BCP42930
Address: 2487 Carmi	chael Street									
Sanitary Connection:#		SIZE:	100mmØ	MATERIAL:	PVC		INV.	722.10m	CONNE	ECTED
Water Connection:#		SIZE:	19mmØ	MATERIAL:	Copper		INV.	721.88m		
Storm Connection:#		SIZE	100mmØ	MATERIAL	PVC		INV.	721.88m	CONNE	ECTED
Cash Receipt No's:			WATER		SANITAR	Υ			STORM	
CURB FROM PROPERTY LINE 5m		5m						PAVEMENT WIDTH 10m		
HYDRO	75mm DB2				U/G CONNI	ECTION	1	/		
TELEPHONE	100mm DB2				U/G CONNI	ECTION	1	/		
GAS	42 PROP/P.E.									
Information Sheets:	RE	F. DWGS.	L&M ENGINEE	RING LTD. JOB.	1273-05-0	4 DWG	SS. (00	1-307)		
Comments:	CS CURE			WATER SERVICE STORM SERVICE SANITARY SERV	ICE	===	HYDRO CABLE TELECO	SERVICE SERVICE OMMUNICASTI	— GAS —	- GAS - ELECTRICAL

THE INFORMATION CONTAINED HEREIN IS FOR INTERNAL USE ONLY.

NOT TO BE RELIED UPON UNLESS CONFIRMED BY THE SITE INSPECTION AND/OR INVESTIGATION

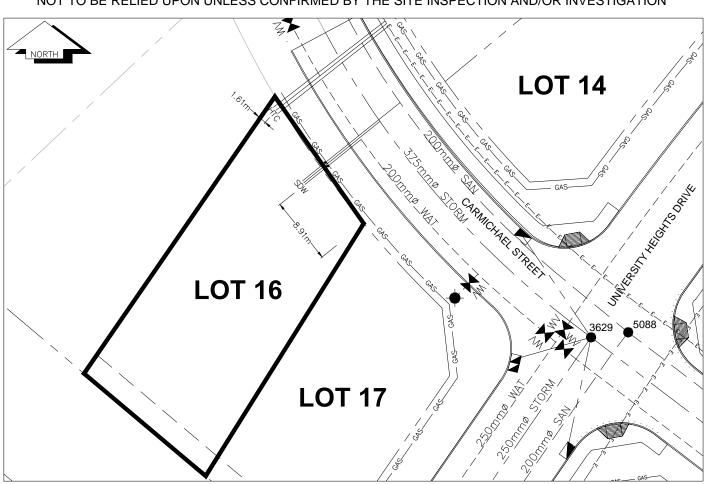

SANITARY, STORM & WATER SERVICE INVERTS	SANITARY	WATER	STORM
1. Distance from San. M.H. $\underline{5089}$ toward San. M.H. $\underline{5088}$ to lot service connection point is:	30m	N/A	N/A
1a.Distance from Stm. M.H. 3630 toward Stm. M.H. 3629 to lot service connection point is:	N/A	N/A	27m
2. Main Size at connection point is	200mmØ	200mmØ	375mmØ
3. Invert of main at conn. stub point is	721.49m	720.99m	721.25m
4. Invert at service end is	722.10m	721.88m	721.88m
5. Cover at property line in meters	2.54m	2.84m	2.76m
6. Survey DateMAY 2010 Book Ref.:1273-05-03 By: Pierre Dorion			
			1
SANITARY HISTORY:			
DATE INSTALLED: AUGUST 2009			
INSTALLED BY: PROGRESSIVE CONTRACTORS LTD.			
WATER HIGTORY			
WATER HISTORY:			
DATE INSTALLED: AUGUST 2009			
INSTALLED BY: PROGRESSIVE CONTRACTORS LTD.			
STORM HISTORY:			
DATE INSTALLED: AUGUST 2009			
INSTALLED BY: PROGRESSIVE CONTRACTORS LTD.			