

City of Prince George

HISTORY SHEET

P.I.D. 028134338

Legal: ~~XXXX~~ LOT A

D.L. 747

PLAN BCP 43608

Address: 2001 INDUSTRIAL WAY

Sanitary Connection: SIZE: ON-SITE MATERIAL: N/A INV. N/A CONNECTED

Water Connection: SIZE: N/A 50mm MATERIAL: N/A INV. N/A METER

Storm Connection: SIZE: N/A MATERIAL: N/A INV. N/A CONNECTED

Cash Receipt No's: WATER 23350 SANITARY STORM

CURB FROM PROPERTY LINE 9.7m PAVEMENT WIDTH 10.0m

B.C. HYDRO O.H. U/G CONNECTION

B.C. TELEPHONE U/G U/G CONNECTION ✓


B.C. GAS N/A

SCALE: 1:7,500

INFORMATION FOR WATER AND SANITARY TAKEN FROM PREVIOUS CoPG HISTORY SHEET
Information Sheets: REF. DWGS. L&M ENGINEERING LTD. JOB. 1126-13-3.4 DWGS.(001-501)

Comments: CS CURB STOP --- W WATER SERVICE --- H HYDRO SERVICE
CO CLEAN OUT --- S STORM SERVICE --- C CABLE SERVICE
GAS GAS
E ELECTRICAL

THE INFORMATION CONTAINED HEREIN IS FOR INTERNAL USE ONLY.
NOT TO BE RELIED UPON UNLESS CONFIRMED BY THE SITE INSPECTION AND/OR INVESTIGATION

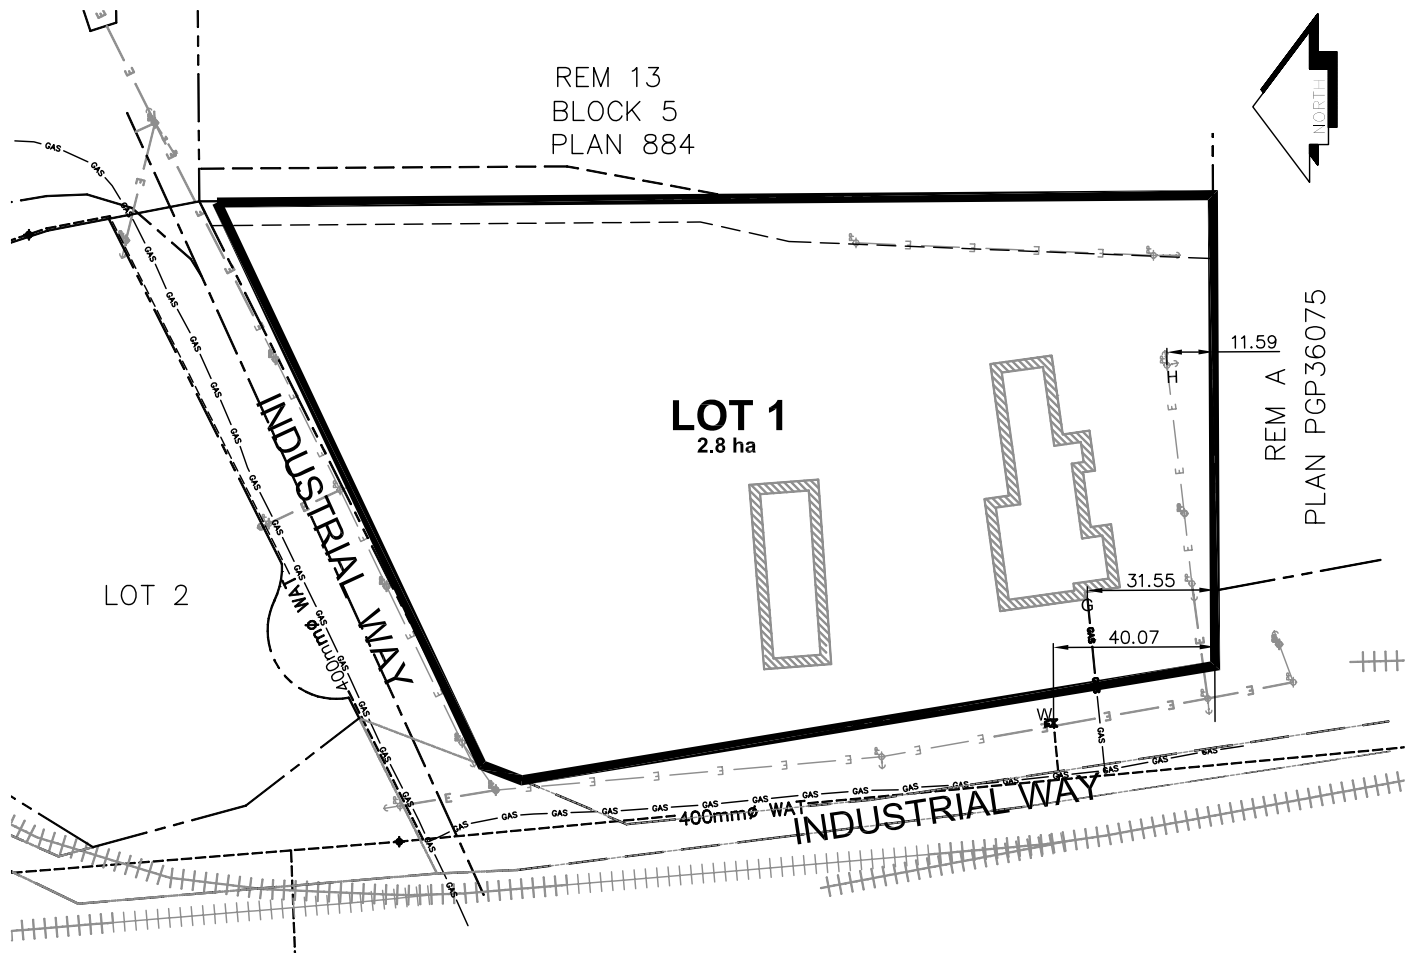

SANITARY, WATER & STORM SERVICE INVERTS	SANITARY	WATER	STORM
1. Distance from San. M.H. to connection point is toward San. M.H.	N/A	N/A	N/A
1a.Distance from Stm. M.H. to connection point is toward Stm. M.H.	N/A	N/A	N/A
2. Main Size at connection point is	N/A	N/A	N/A
3. Invert of main at conn. stub pt is	N/A	N/A	N/A
4. Invert at service end is	N/A	N/A	N/A
5. Cut at P/I in meters	N/A	N/A	N/A
6. Survey Date: SEPTEMBER 2006 Book Ref. 1126-13-3.4 by ALLNORTH			

SANITARY HISTORY:

WATER HISTORY:

STORM HISTORY:
