


## Lot Servicing

369 MOFFAT ST

PID: 028135300

**Lot:** PCL C, **Block:** 72, **Plan:** 752, **DL:** 937

SERVICE	SIZE	MATERIAL	INSTALLED DATE	LOCATION	DETAILS
WATER	20MM	CU	17-Jul-1957	FR NE COR BLD 13.7M E	CONNECTION NUMBER 1207
SANITARY	UNKNOWN	UNKNOWN		1.219M S OF NE COR PL	CONNECTION # 3152

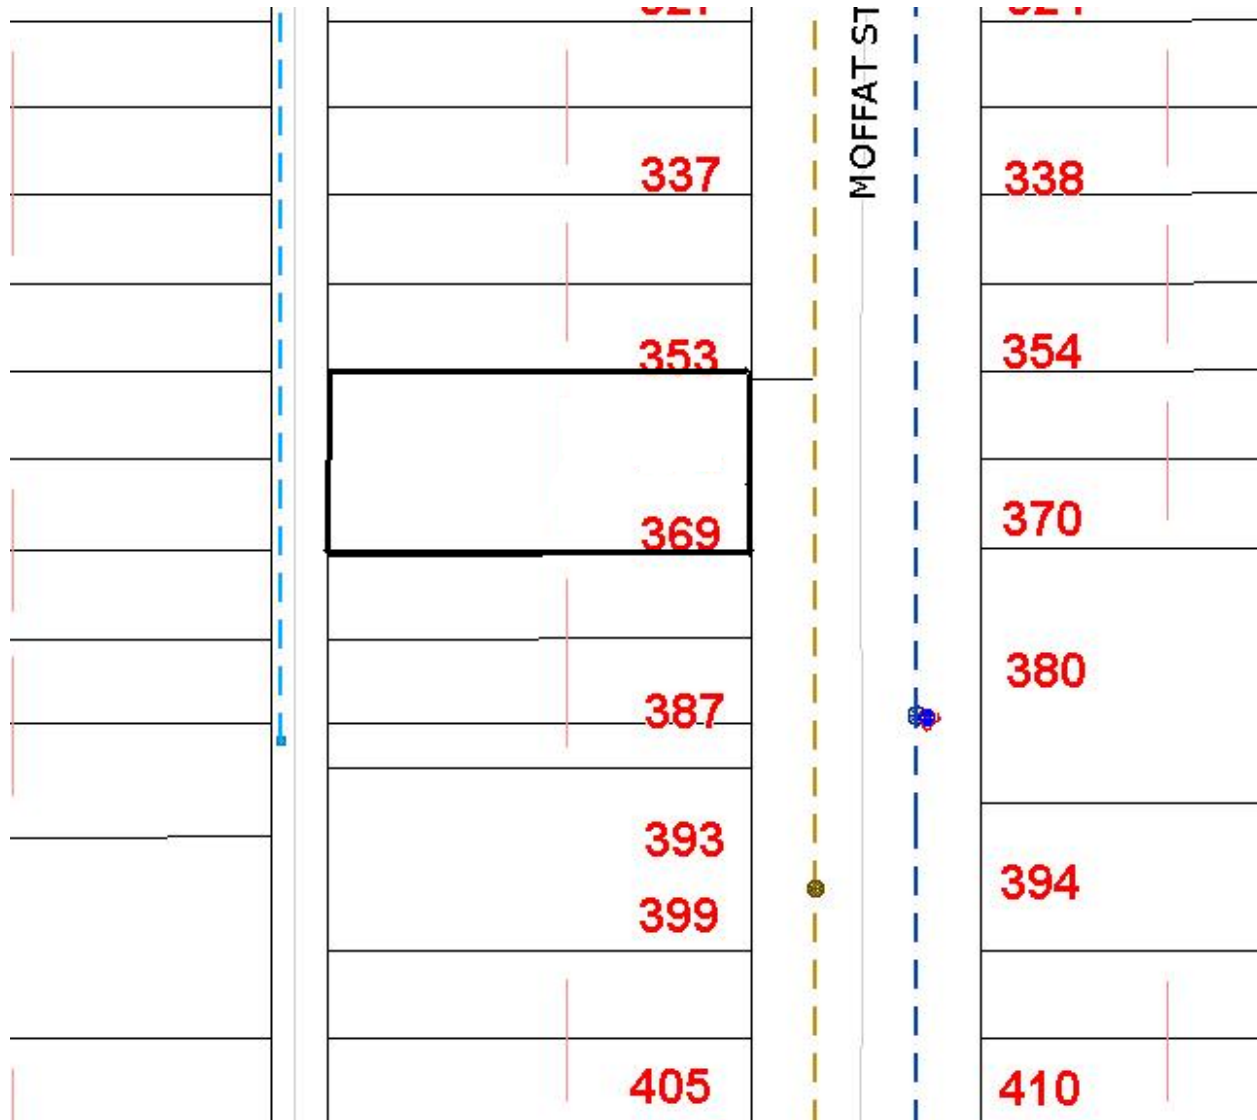

Accuracy not guaranteed unless confirmed by site inspection and/or investigation.  
Connection location between main and property line only.