
Lot Servicing

2224 2ND AVE PID: 028165632

Lot: B, Block: 50, Plan: 1268, DL: 343 BB1454682

SERVICE	SIZE	MATERIAL	INSTALLED DATE	LOCATION	DETAILS
WATER	UNKNOWN	UNKNOWN		NO LOCATION	
SANITARY	100MM	UNKNOWN		NO LOCATION	CONNECTION # 2235

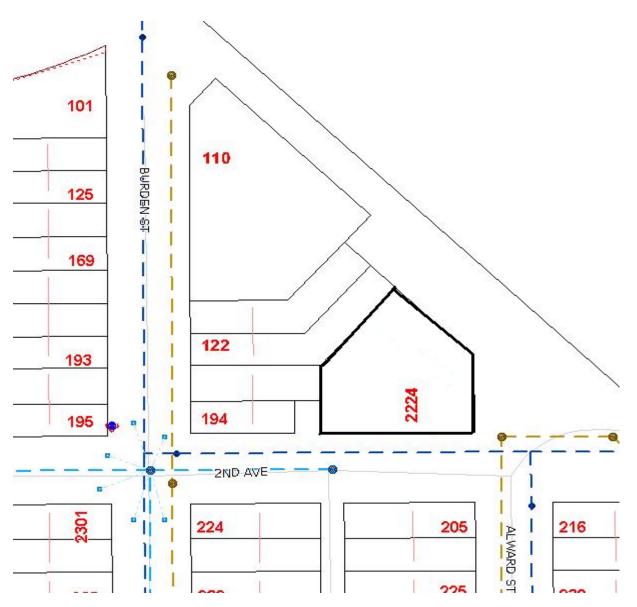

Accuracy not guaranteed unless confirmed by site inspection and/or investigation. Connection location between main and property line only.