


## Lot Servicing

206 IRWIN ST 2995 2ND AVE

PID: 028171471

**Lot:** PCL A, **Block:** 85, **Plan:** 752, **DL:** 937 (BB1455346)

| SERVICE  | SIZE    | MATERIAL | INSTALLED DATE | LOCATION              | DETAILS                |
|----------|---------|----------|----------------|-----------------------|------------------------|
| WATER    | UNKNOWN | UNKNOWN  | 10-Oct-1958    | FR SW CORN BLDG 10M W | CONNECTION NUMBER 1226 |
| SANITARY | UNKNOWN | UNKNOWN  |                | NO LOCATION           | CONNECTION # 394       |

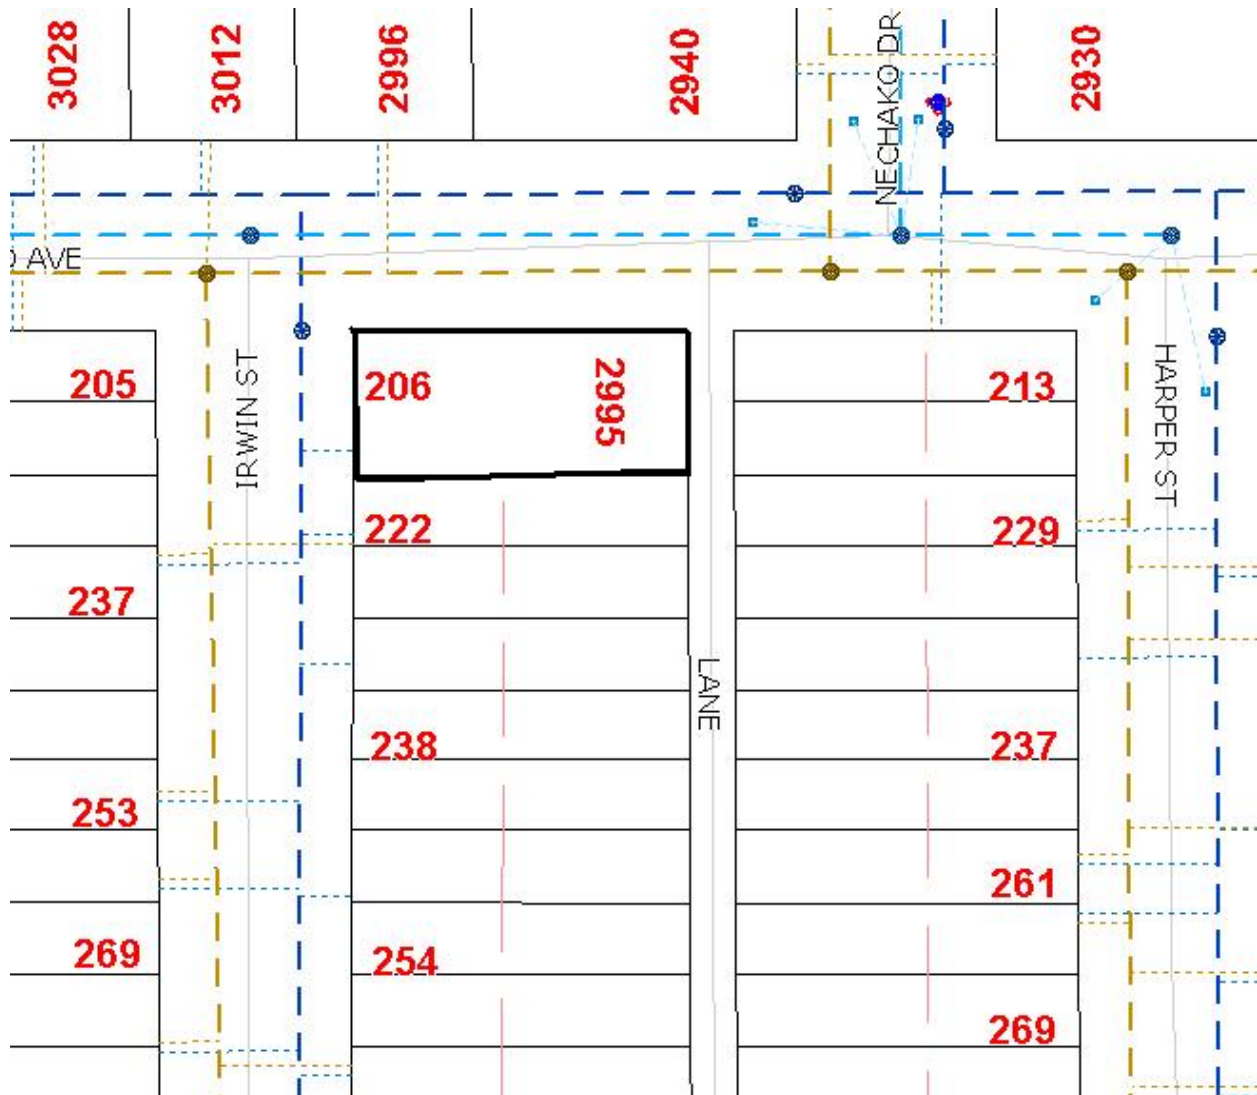

Accuracy not guaranteed unless confirmed by site inspection and/or investigation.  
Connection location between main and property line only.