

City of Prince George
HISTORY SHEET

P.I.D. 028174615

Legal: LOT A

D.L. 745 & 747

PLAN BCP 44065

Address: 1154 PACIFIC STREET

Sanitary Connection: SIZE: 100mmØ MATERIAL: N/A INV. N/A CONNECTED

Water Connection: SIZE: 150mmØ & 25mmØ MATERIAL: N/A INV. N/A METER

Storm Connection: SIZE: 200mmØ MATERIAL: PVC INV. 590.63m CONNECTED

Cash Receipt No's: WATER SANITARY STORM

CURB FROM PROPERTY LINE 6.5m PAVEMENT WIDTH 10.5m

B.C. HYDRO O.H. U/G CONNECTION

B.C. TELEPHONE U/G U/G CONNECTION


B.C. GAS 168DP

SCALE: 1:6000

INFORMATION FOR WATER AND SANITARY TAKEN FROM PREVIOUS CoPG HISTORY SHEET
Information Sheets: REF. DWGS. L&M ENGINEERING LTD. JOB. 1126-13-3.4 DWGS.(001-501)

Comments: C.S. CURB STOP SDW WATER SERVICE TCH HYDRO SERVICE
C.O. CLEAN OUT S.S. STORM SERVICE CBL CABLE SERVICE
E ELECTRICAL

THE INFORMATION CONTAINED HEREIN IS FOR INTERNAL USE ONLY.
NOT TO BE RELIED UPON UNLESS CONFIRMED BY THE SITE INSPECTION AND/OR INVESTIGATION

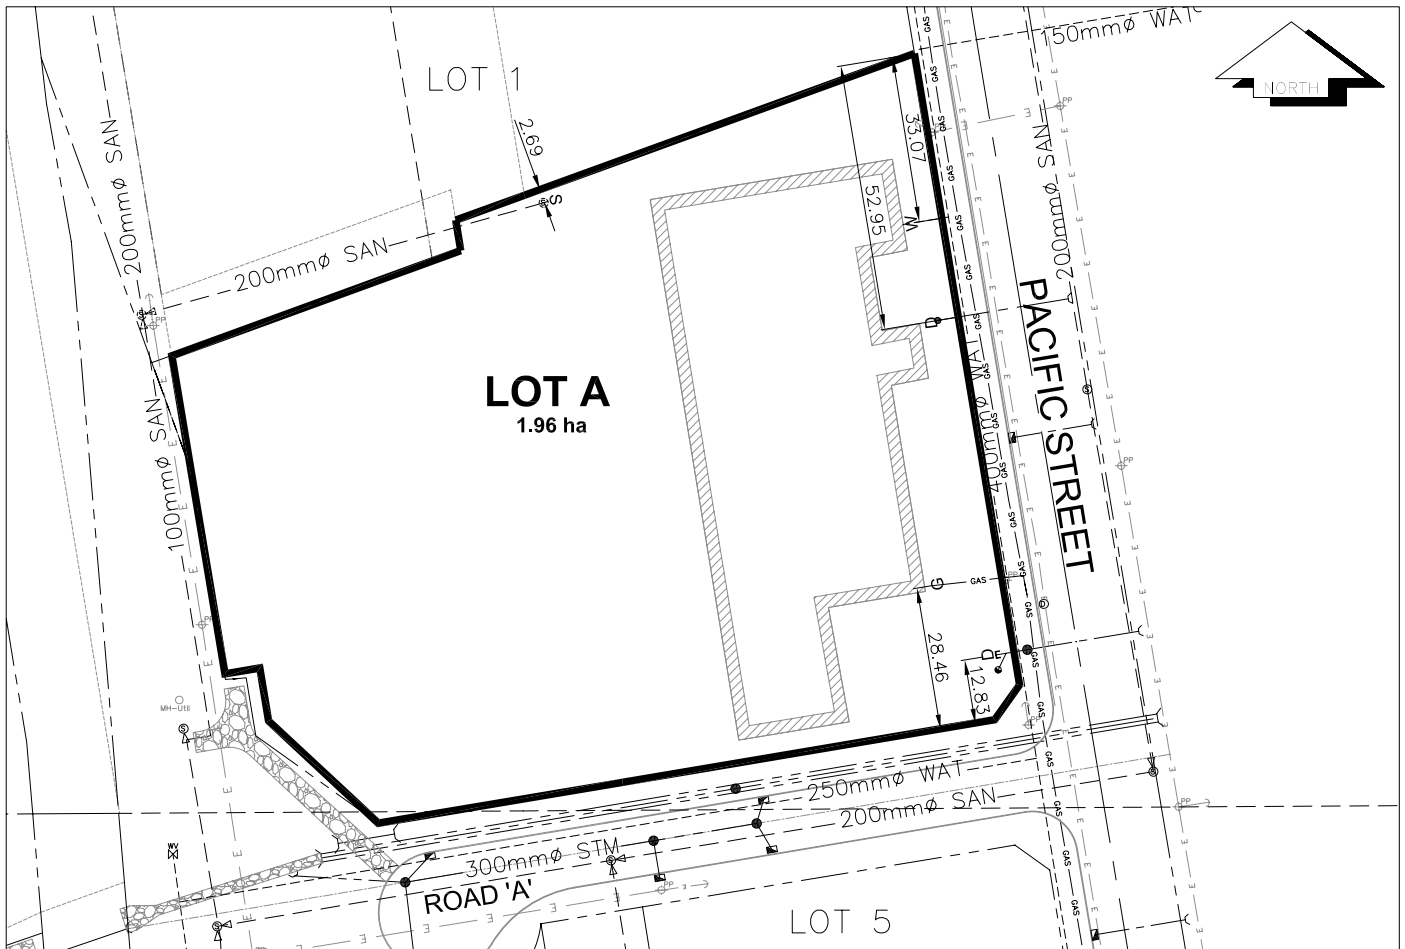

SANITARY, WATER & STORM SERVICE INVERTS	SANITARY	WATER	STORM
1. Distance from San. M.H. to connection point is toward San. M.H.	N/A	N/A	N/A
1a.Distance from Stm. M.H. to connection point is toward Stm. M.H.	N/A	N/A	N/A
2. Main Size at connection point is	200mmØ	400mmØ	450mmØ
3. Invert of main at conn. stub pt is	N/A	N/A	590.50
4. Invert at service end is	N/A	N/A	590.63
5. Cut at P/I in meters	N/A	N/A	1.6m
6. Survey Date: SEPTEMBER 2006 Book Ref. 1126-13-3.4 by ALLNORTH			

SANITARY HISTORY:

WATER HISTORY:

STORM HISTORY:
