


Lot Servicing

4118 HART HWY

PID: 028177088

Lot: 1, Plan: EPP1303, DL: 4040

SERVICE	SIZE	MATERIAL	INSTALLED DATE	LOCATION	DETAILS
WATER	20MM	CU		27.5M S NW COR PL	THAW WIRE Y
SANITARY	100MM	UNKNOWN	01-Oct-1979	6.096M N SW COR PL	CONNECTION # 12641

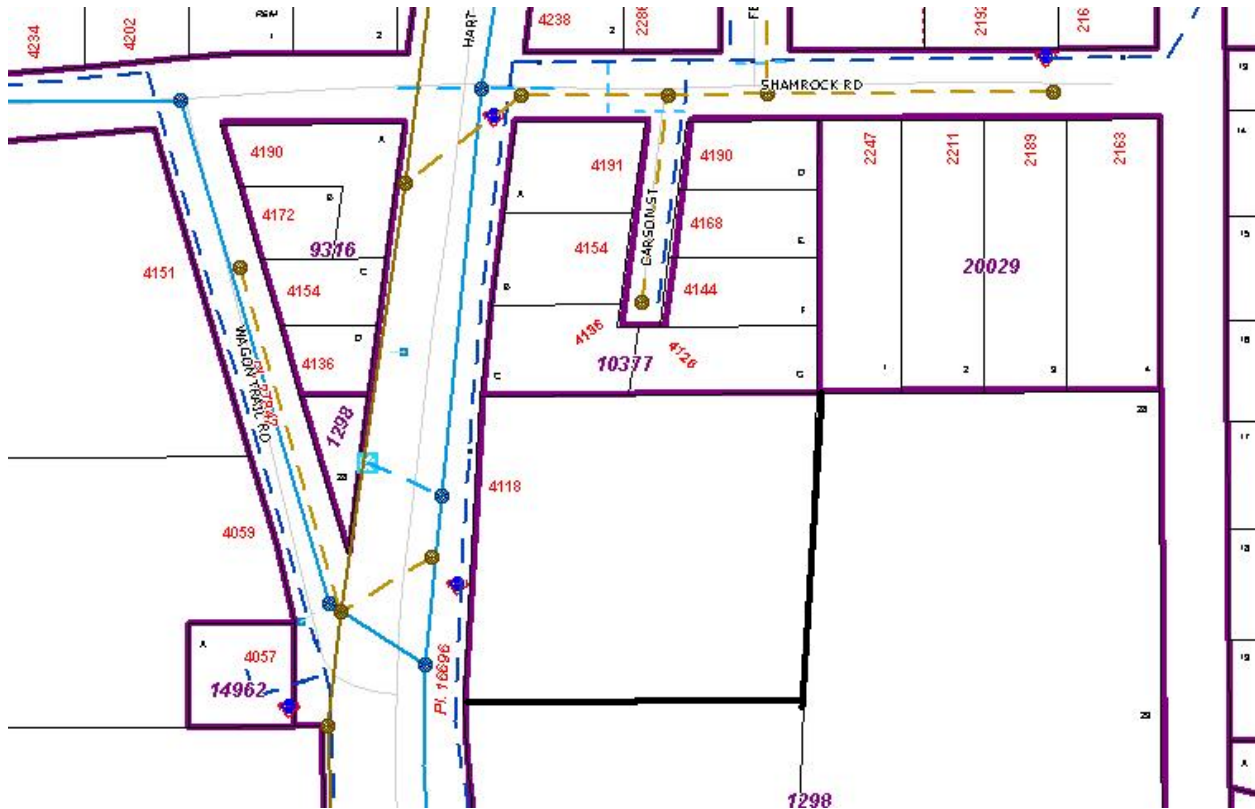

Accuracy not guaranteed unless confirmed by site inspection and/or investigation.
Connection location between main and property line only.