


Lot Servicing

4032 HART HWY

PID: 028177096

Lot: 2, Plan: EPP1303, DL: 4040

SERVICE	SIZE	MATERIAL	INSTALLED DATE	LOCATION	DETAILS
WATER	50MM	UNKNOWN	12-Jun-2000	40.0M S N PL	CASH RECEIPT NUMBER 100027
SANITARY	100MM	UNKNOWN	01-Oct-1979	20' S N PL	CONNECTION # 12642

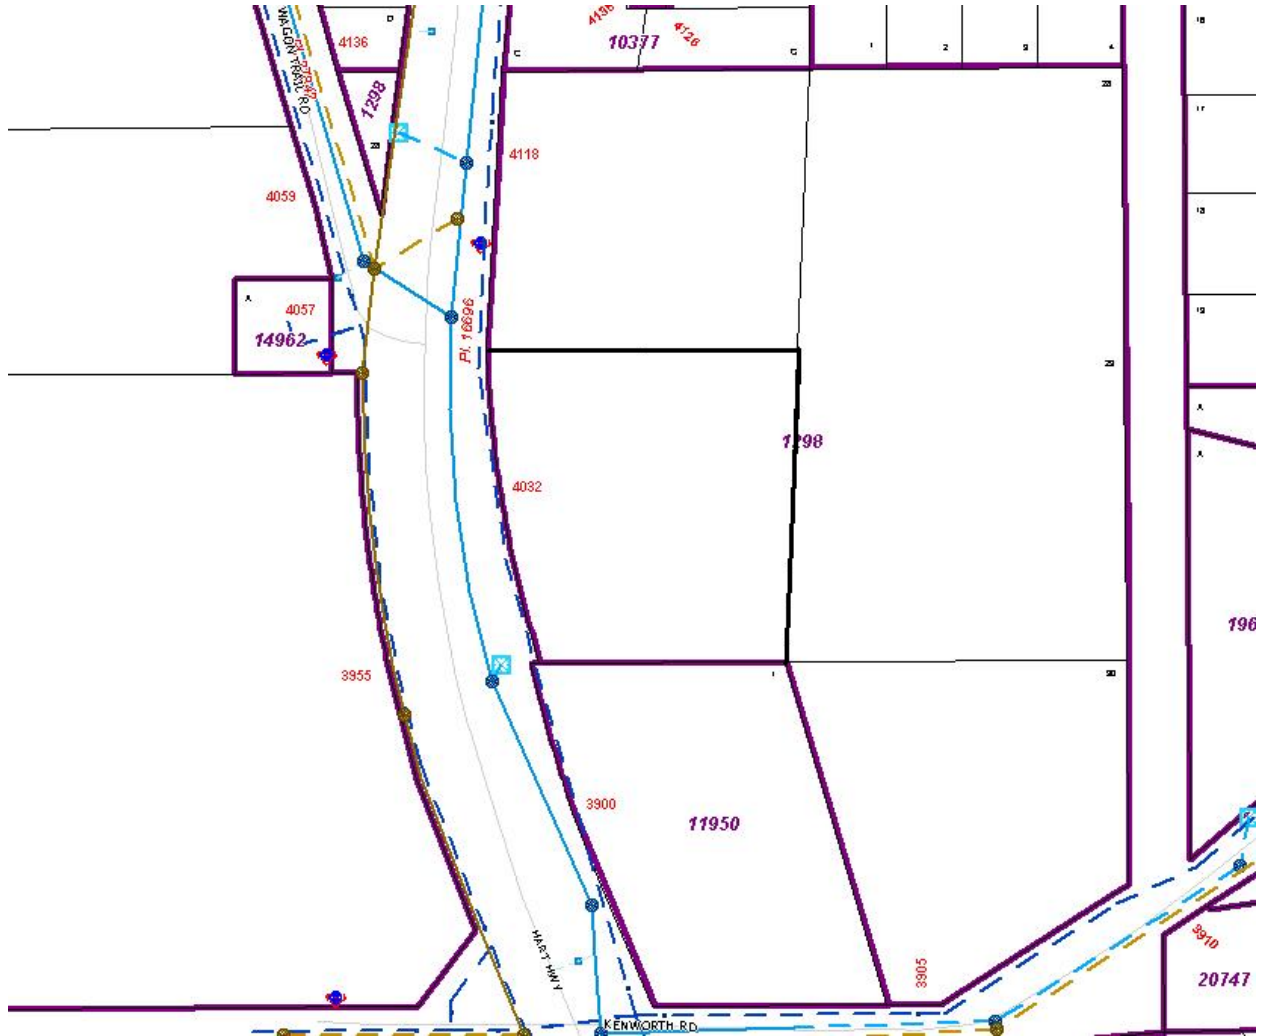

Accuracy not guaranteed unless confirmed by site inspection and/or investigation.
Connection location between main and property line only.