


### Lot Servicing

7364 HART HWY

PID: 028193211

Lot: A, Plan: BCP44073, DL: 2433

SERVICE	SIZE	MATERIAL	INSTALLED DATE	LOCATION	DETAILS
WATER	150MM	CU	04-Jul-1996	NO LOCATION	CASH RECEIPT NUMBER 17160
WATER	200MM	UNKNOWN		NEW SERVICE NO LOCATION	CASH RECEIPT NUMBER 101037
SANITARY	200MM	PVC	04-Jul-1996	NO LOCATION	DIFF OR CUT BELOW @ P/L 2.3M

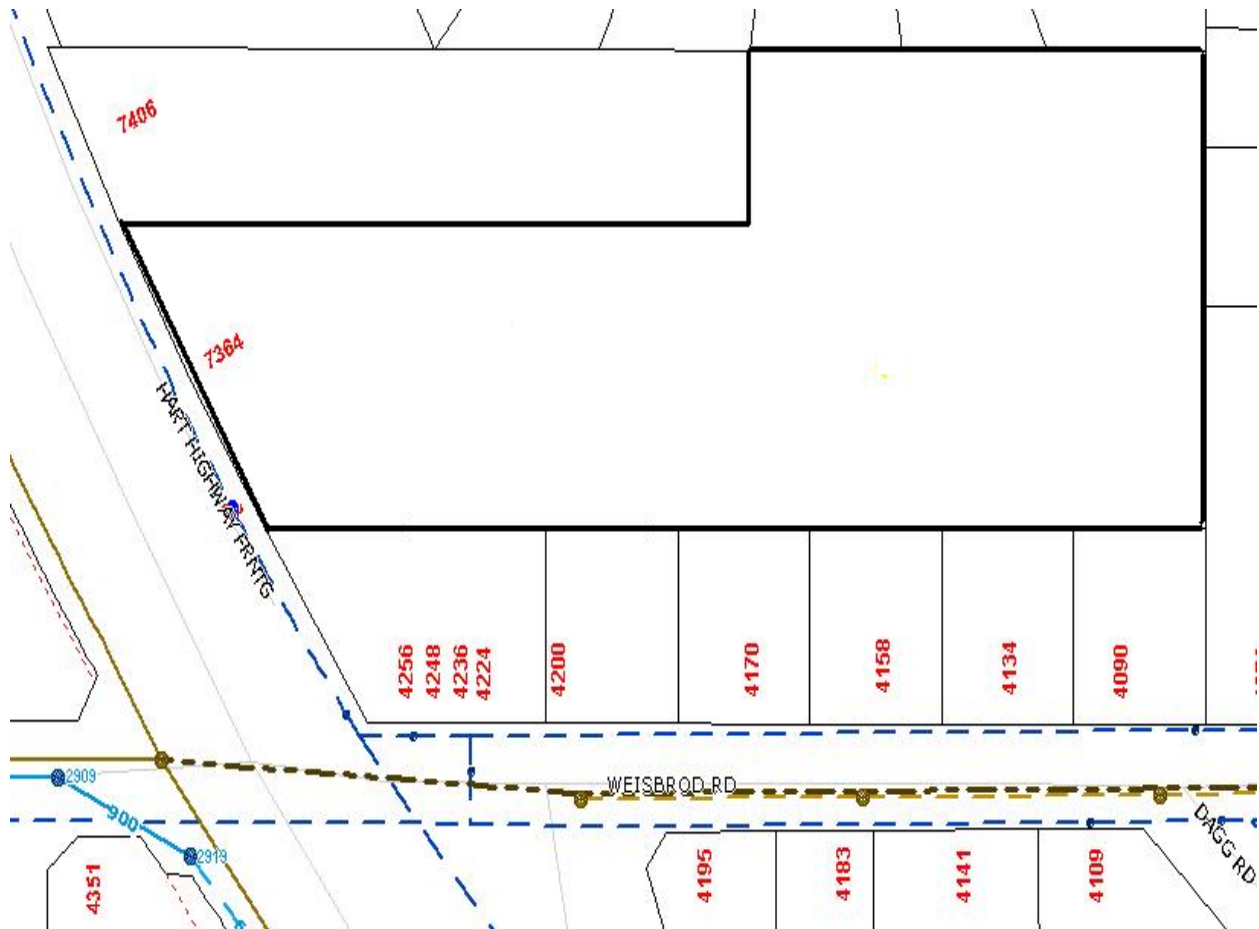

Accuracy not guaranteed unless confirmed by site inspection and/or investigation.  
Connection location between main and property line only.