

City of Prince George
HISTORY SHEET

028213068

PID:

Scale: 1:500

Legal: **A**

D.L.: 1605

EPP7155

Address: 7688 EASTVIEW STREET

Sanitary Connection:# SIZE: 100mmØ MATERIAL PVC INV. 691.30m CONNECTED

Water Connection:# SIZE: 19mmØ MATERIAL: COPPER INV. 690.91m

Storm Connection:# SIZE 100mmØ MATERIAL PVC INV. 691.30m CONNECTED

Cash Receipt No's: WATER SANITARY STORM

CURB FROM PROPERTY LINE 5m PAVEMENT WIDTH 10m

B.C. HYDRO 75mm DB2 U/G CONNECTION ✓

B.C. TELEPHONE 50mm DB2 U/G CONNECTION ✓


B.C. GAS 42 PROP /P.E

Information Sheets: REF. DWGS. L&M ENGINEERING LTD. JOB. 1106-06-04 DWGS. (001-306)

Comments: CS CURB STOP CO CLEAN OUT SDW WATER SERVICE STORM SERVICE SANITARY SERVICE TCH HYDRO SERVICE CABLE SERVICE TELECOMMUNICATIONS CAS GAS E ELECTRICAL

THE INFORMATION CONTAINED HEREIN IS FOR INTERNAL USE ONLY.

NOT TO BE RELIED UPON UNLESS CONFIRMED BY THE SITE INSPECTION AND/OR INVESTIGATION

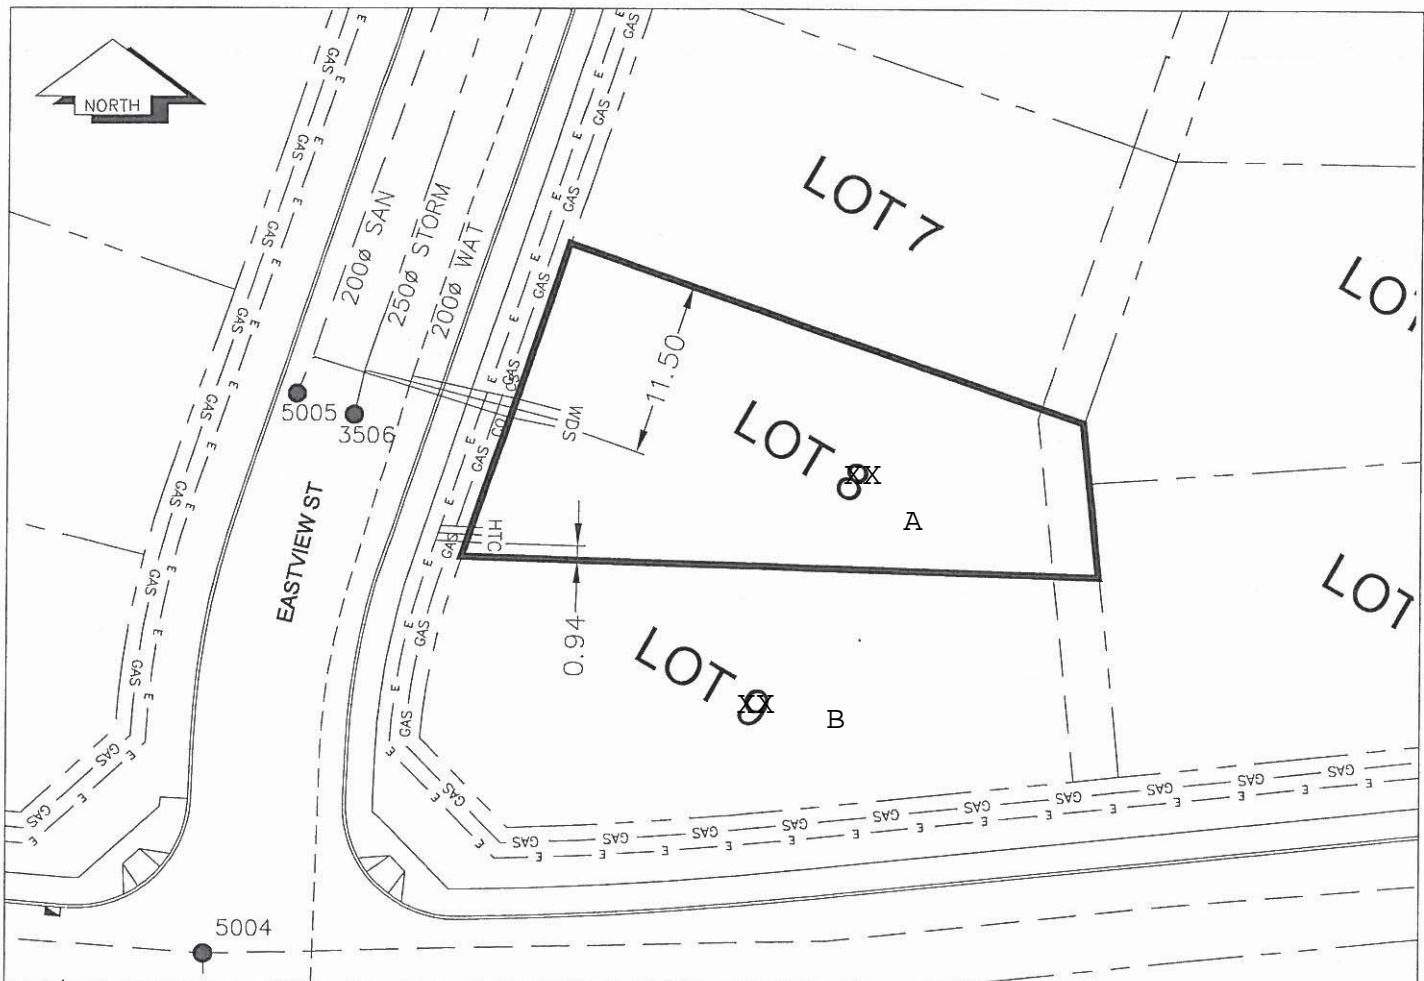

SANITARY, STORM & WATER SERVICE INVERTS	SANITARY	WATER	STORM
1. Distance from San. M.H. 5005 toward San. M.H. Stub to lot service connection point is:	1.5m	N/A	N/A
1a. Distance from Strm. M.H. 3506 toward Strm. M.H. 3507 to lot service connection point is:	N/A	N/A	1.5m
2. Main Size at connection point is	200mmØ	200mmØ	250mmØ
3. Invert of main at conn. stub pt is	690.66m	690.18m	690.96m
4. Invert at service end is	691.30m	690.91m	691.30m
5. Cover at P/L in meters	2.15m	2.64m	2.15m
6. Survey Date: NOV,14,07 Book Ref.: 1106-06-03 By: FORESIGHT			

SANITARY HISTORY:

DATE INSTALLED: AUGUST 2007

INSTALLED BY: WESTERN INDUSTRIAL CONTRACTORS LTD

WATER HISTORY:

DATE INSTALLED: AUGUST 2007

INSTALLED BY: WESTERN INDUSTRIAL CONTRACTORS LTD

STORM HISTORY:

DATE INSTALLED: AUGUST 2007

INSTALLED BY: WESTERN INDUSTRIAL CONTRACTORS LTD