


## Lot Servicing

1169 REBELO DR

PID: 028223861

**Lot:** A, **Plan:** BCP44819, **DL:** 1530

SERVICE	SIZE	MATERIAL	INSTALLED DATE	LOCATION	DETAILS
WATER	19MM	CU		14.773M N OF S PL	
SANITARY	100MM	PVC		14.773M N OF S PL	DIFF OR CUT BELOW @ P/L 2.53M
STORM	100MM	PVC		14.773M N OF S PL	DIFF OR CUT @ P/L 2.54M

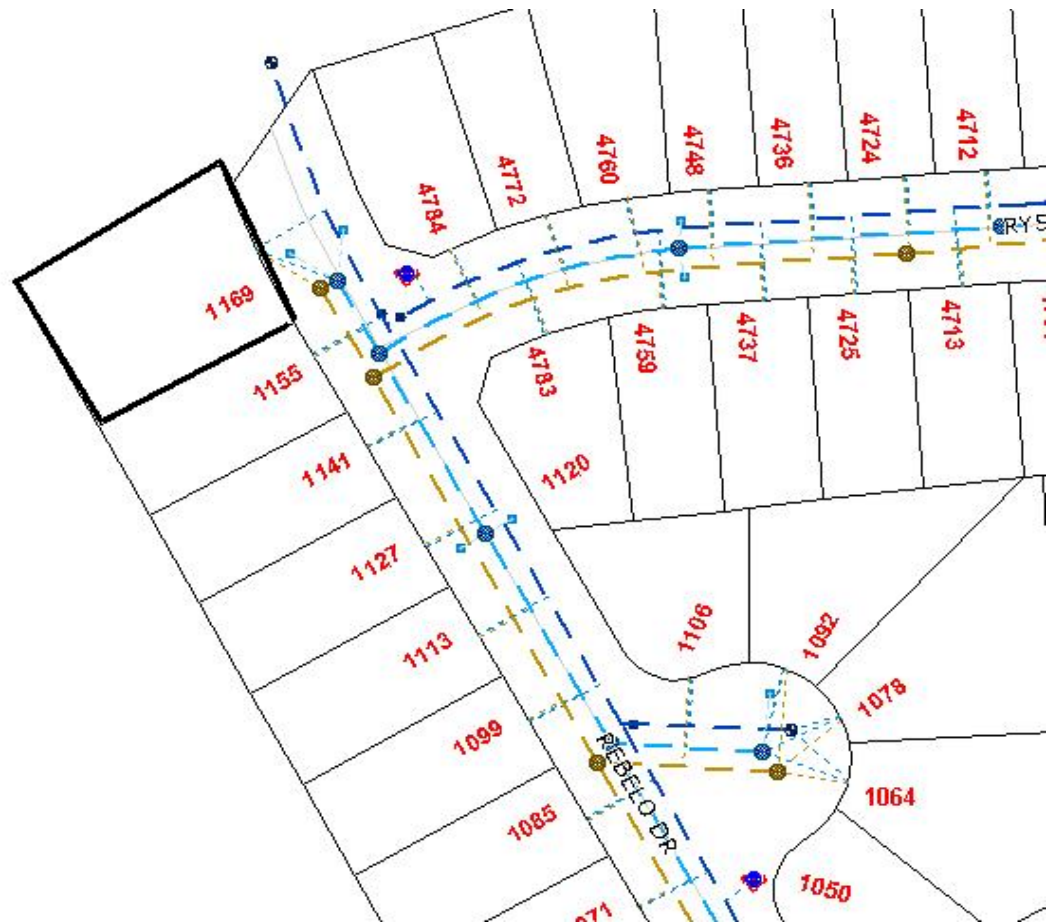

Accuracy not guaranteed unless confirmed by site inspection and/or investigation.  
Connection location between main and property line only.