



City of Prince George
History Sheet

PID:	028267389
SD/MU:	
WO:	

Civic Address: 1672 7th Ave

Legal Description: Lot: PCL C Block: 175 (CA1622154) District Lot: 343 Plan: 1268


Service Type	Diameter (mm)	Material	Invert Elev at main (m)	Depth of cut at property line (m)	Invert Elev at service end (m)	Distance into property (m)	Installation Date
Sanitary	100mm	PVC	575.52	1.83	575.77	-	June 1971
Water	20mm	Copper	-	-	-	-	January 1977
Storm	N/A	N/A	-	-	-	-	

Service Connection Location				Sanitary (m)	Storm (m)
Distance from downstream San MH	3096	towards upstream San MH	2001	92.50	
Distance from downstream Stm MH	-	towards upstream Stm MH	-		

Power	Size	Communications	Size	Cable	Size	Gas	Size
BC Hydro	-	Telus	-	Shaw	-	FortisBC	-
Overhead Service		Overhead Service		Overhead Service			

Installed by:	Survey Date:	-
Comments:		

NOT TO SCALE The information contained herein is for internal use only.
Not to be relied on unless confirmed by site inspection and/or investigation.

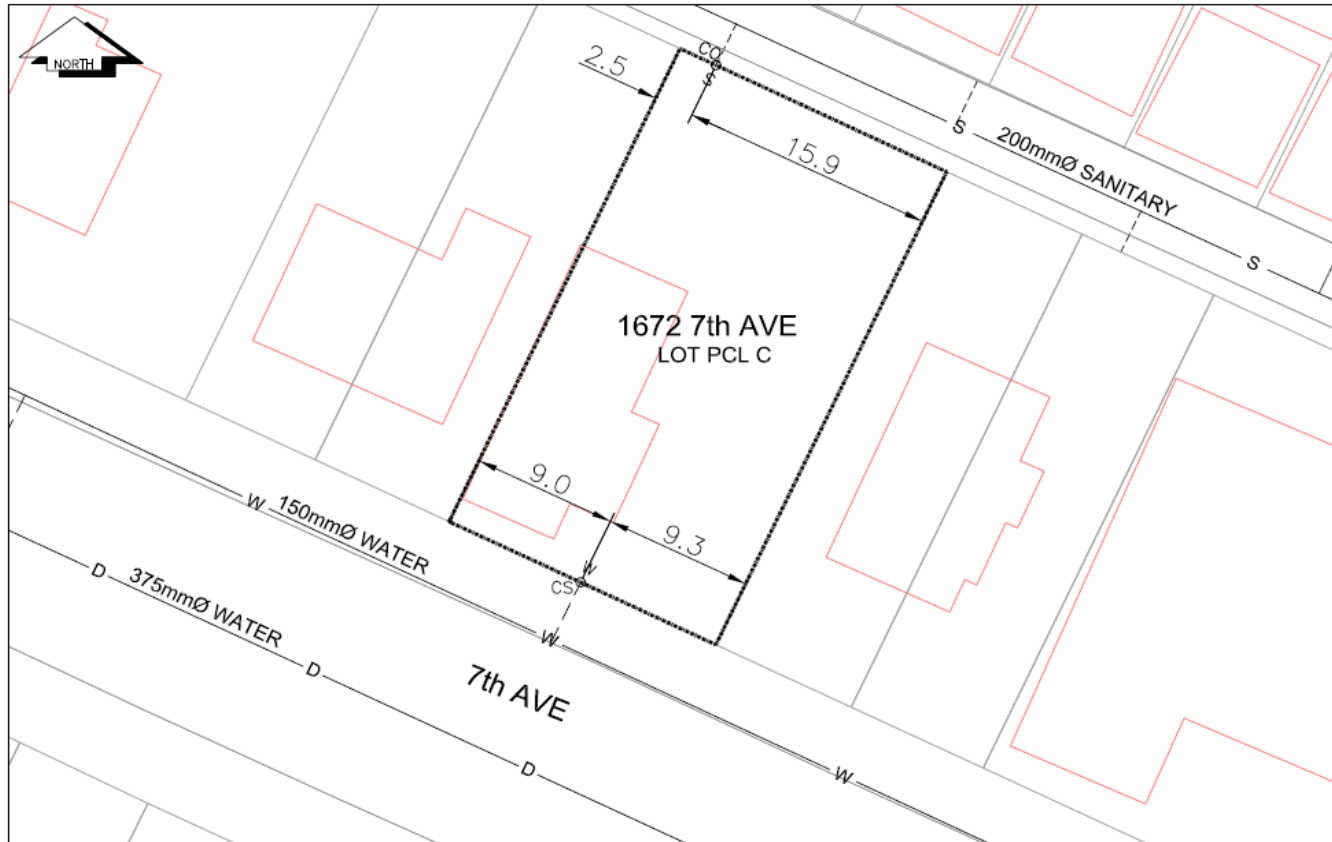

LEGEND:	CS ^o CURB STOP	--- W WATER SERVICE	--- S STORM SERVICE
	CO ^o CLEAN OUT	--- S SANITARY SERVICE	⊗ WATER VALVE

NOT TO SCALE