



City of Prince George History Sheet

PID:	028327675
MU:	101415
WO:	74954

Civic Address: 8222 Willow Cale Rd

Legal Description: Lot: 4 District Lot: 749 Plan: BCP45810


Service Type	Diameter (mm)	Material	Invert Elev at main (m)	Invert Elev at property line (m)	Invert Elev at service end (m)	Distance into property (m)	Installation Date
Sanitary	N/A	N/A	-	-	-	-	-
Water	250mm	PVC	-	-	-	-	Oct 2014
Storm	N/A	N/A	-	-	-	-	-

Service Connection Location					Sanitary (m)	Storm (m)
Distance from downstream San MH			-	towards upstream San MH	-	-
Distance from downstream Stm MH			-	towards upstream Stm MH	-	-

Power	Size	Communications	Size	Cable	Size	Gas	Size
BC Hydro	-	Telus	-	Shaw	-	FortisBC	-
Overhead Service		Overhead Service		Overhead Service			

Installed by:	City of Prince George forces	Survey Date:	-
Comments:	Onsite fire water system connected to CoPG water system		

NOT TO SCALE The information contained herein is for internal use only.
Not to be relied on unless confirmed by site inspection and/or investigation.

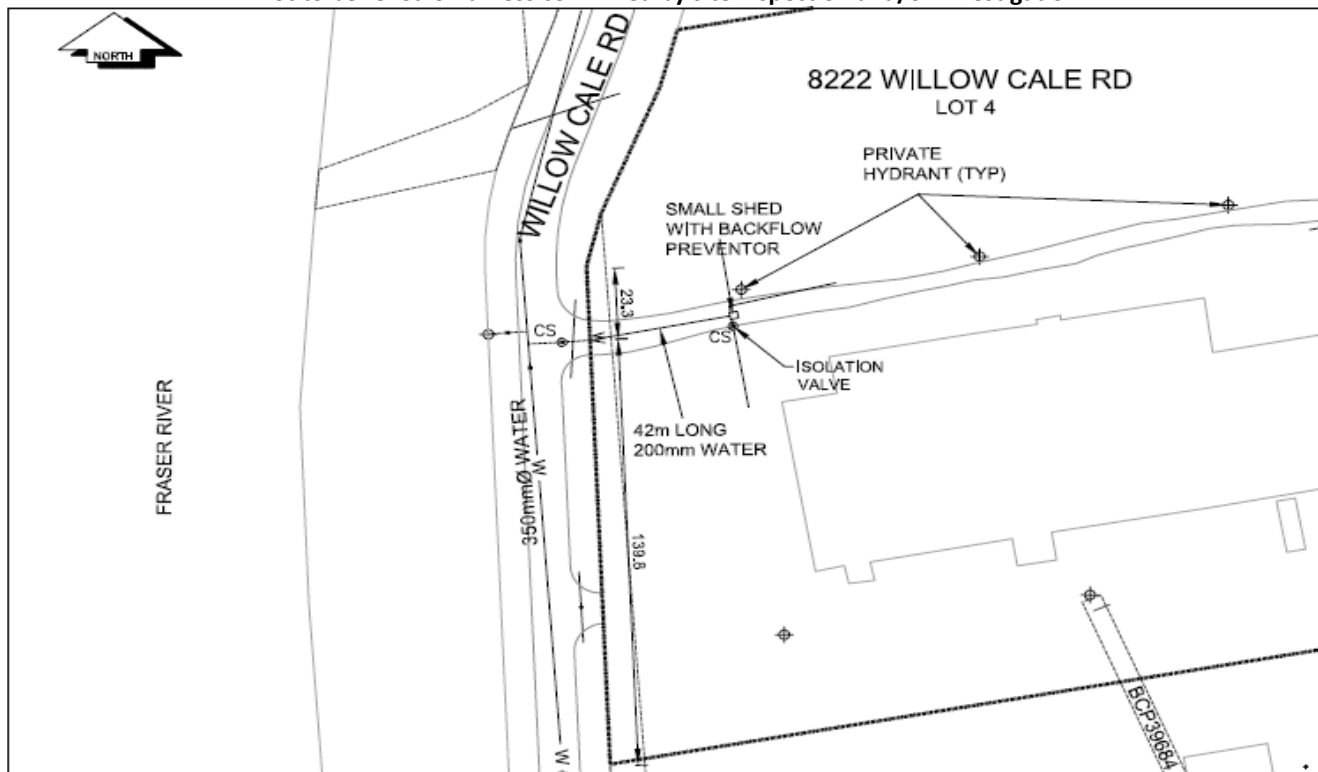

LEGEND:	CS CURB STOP	--- W WATER SERVICE	--- S SANITARY SERVICE	--- STORM SERVICE	⊗ WATER VALVE
	CO CLEAN OUT				

NOT TO SCALE