



City of Prince George History Sheet

PID:	028327683
MU:	101415
WO:	76173

Civic Address: 8545 8546 Willow Cale Rd

Legal Description: Lot: 5 District Lot: 749 Plan: BCP45810


Service Type	Diameter (mm)	Material	Invert Elev at main (m)	Invert Elev at property line (m)	Invert Elev at service end (m)	Distance into property (m)	Installation Date
Sanitary	N/A	N/A	-	-	-	-	-
Water - (W1)	250mm	PVC	-	-	-	-	January 2014
Water - (W2)	50mm	Copper	-	-	-	-	December 1984
Water - (W3)	150mm	PVC	-	-	-	-	December 1984
Water - (W4)	250mm	PVC	-	-	-	-	December 1984
Storm	N/A	N/A	-	-	-	-	-

Service Connection Location					Sanitary (m)	Storm (m)
Distance from downstream San MH	-	towards upstream San MH	-	-	-	-
Distance from downstream Stm MH	-	towards upstream Stm MH	-	-	-	-

Power	Size	Communications	Size	Cable	Size	Gas	Size
BC Hydro	-	Telus	-	Shaw	-	FortisBC	-
Overhead Service		Overhead Service		Overhead Service			

Installed by:	Survey Date:	-
Comments:	Water service fo west part of parcel located on June 27, 2018	
	See Eng Dwg 3264 (eDoc 25892)	

NOT TO SCALE The information contained herein is for internal use only.
Not to be relied on unless confirmed by site inspection and/or investigation.

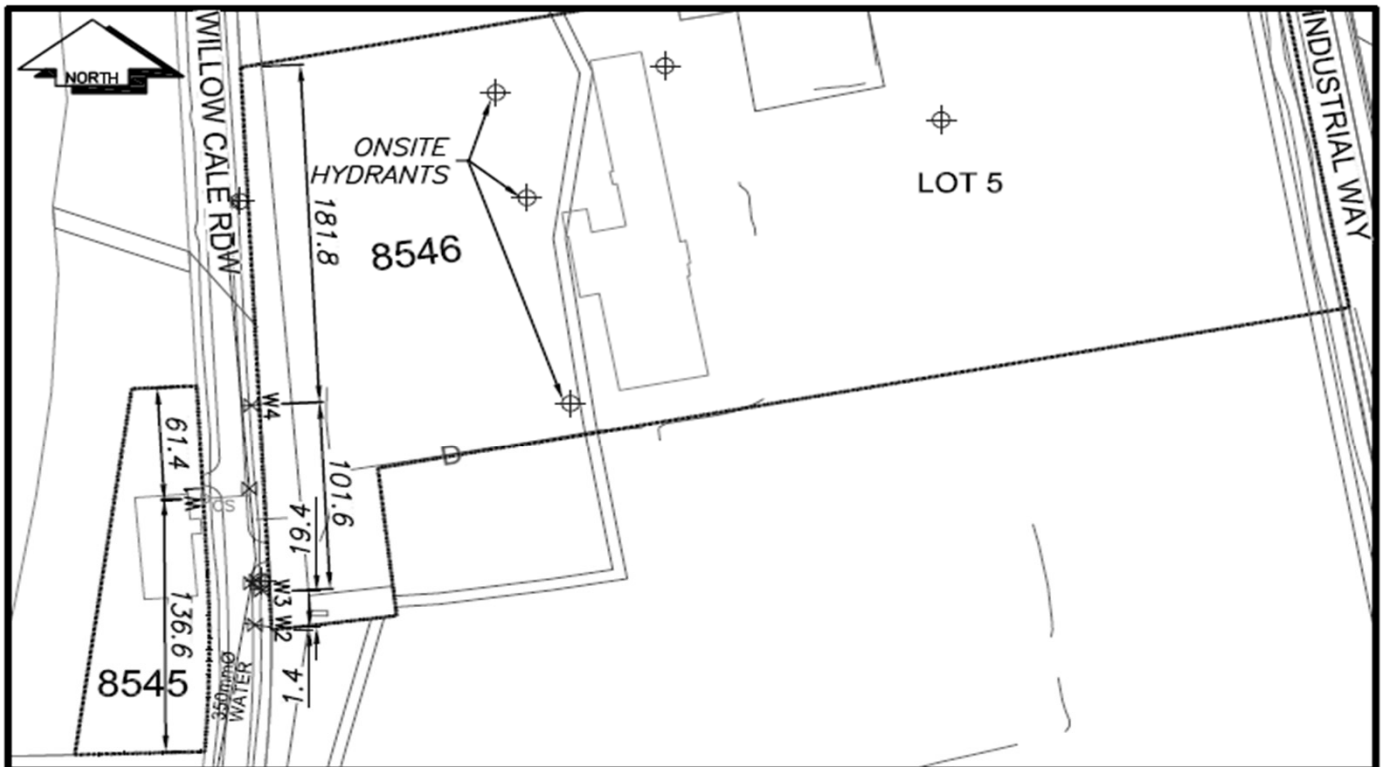

CS ^o CURB STOP	— — — — — WATER SERVICE	— — — — — STORM SERVICE
CO ^o CLEAN OUT	— — — — — SANITARY SERVICE	— — — — — GAS
⊗ WATER VALVE	⊗ FIRE HYDRANT	— — — — — ENCUMBERANCE

NOT TO SCALE