
## City of Prince George HISTORY SHEET

PID: . 02833		Sc	ale: 1:500				
Legal: LOT 2				D.	L.: -201	4	PLAN: EPP5390
Address: - 7403	Creekside Way	7					
Sanitary Connection:#	SIZE	100mmØ	MATERIAL:	PVC	INV.	583.77	CONNECTED
Water Connection:#	SIZE	19mmØ	MATERIAL:	copper	INV.	583.87	METER
Storm Connection:#	SIZE	100mmØ	MATERIAL	PVC	INV.	583.82	CONNECTED
Cash Receipt No's:	- One - On - All	WATER		SANITARY			STORM
CURB FROM PROPER	TY LINE 5m					PAVEME	NT WIDTH 10m
B.C. HYDRO	75mm DB2			U/G CONNEC	TION	/	
B.C. TELEPHONE	50mm DB2			U/G CONNECTION		_/_	
TERASEN	42 PROP/P.E.						
Information Sheets:	REFERENCE DRAWINGS L&M ENGINEERING LIMITED JOB NO. 1140-07-04						
Comments:	CS CURB STOP  CO CLEAN OUT  WATER SERVICE STORM SERVICE SANITARY SERVICE SANITARY SERVICE SANITARY SERVICE  TELECOMMUNICASTIONS  GAS ELECTR					GAS TIONS E ELECTRICAL	

THE INFORMATION CONTAINED HEREIN IS FOR INTERNAL USE ONLY.
NOT TO BE RELIED UPON UNLESS CONFIRMED BY THE SITE INSPECTION AND/OR INVESTIGATION

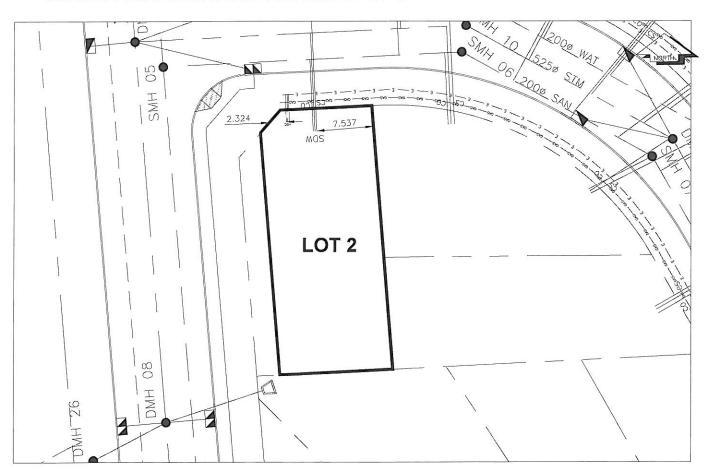

SANITARY, STORM & WATER SERVICE INVERTS	SANITARY	WATER	STORM						
1. Distance from San. M.H. <u>05</u> toward San. M.H. <u>06</u> to lot service connection point is:	19m	N/A	N/A						
1a.Distance from Stm. M.H. 09 toward Stm. M.H. 10 to lot service connection point is:	N/A	N/A	23m						
2. Main Size at connection point is	200mm	200mm	525mm						
3. Invert of main at conn. stub point is	581.78	583.1	582.95						
4. Invert at service end is	583.77	583.87	583.92						
5. Cut at property line in meters	2.69m	2.67m	2.64m						
6. Survey Date: OCT 2009 Book Ref.:1140-07-04 By: FORESIGHT SURVEY & DESIGN									
SANITARY HISTORY:									
Installed By: Fortwood Homes Ltd.									
			4-0 9 8-00100 - 9						
WATER HISTORY:									
Installed By: Fortwood Homes Ltd.									
	-								
	6.00 - 6.00								
		- 20 41							
STORM HISTORY:									
Installed By: Fortwood Homes Ltd.									