
City of Prince George HISTORY SHEET

PID: .0283308	⁸ 54					Scale: 1:500		
Legal: LOT 4				D.L.: 2014				_{PLAN:} EPP5390
Address: 4ጷ፞፞ዾቚፙቚ፟፟፟፟፟፟፟፟፟	745	59 Cree	ekside Way					
Sanitary Connection:#		SIZE:	100mmØ	MATERIAL:	PVC	INV.	584.14	CONNECTED
Water Connection:#		SIZE:	19mmØ	MATERIAL:	copper	INV.	584.24	METER
Storm Connection:#		SIZE	100mmØ	MATERIAL	PVC	INV.	584.21	CONNECTED
Cash Receipt No's:			WATER		SANITAR	RY		STORM
CURB FROM PROPERTY LINE 5m						PAVEME	NT WIDTH 10m	
B.C. HYDRO	75mm DB2			U/G CONNECTION		_/_		
B.C. TELEPHONE	50mm DB2				U/G CONN	ECTION	1	
TERASEN	42 PROP/P.E							
Information Sheets:	REFERENCE DRAWINGS L&M ENGINEERING LIMITED JOB NO. 1140-07-04							
Comments:	CS CURB STOP CO CLEAN OUT WATER SERVICE STORM SERVICE SANITARY SERVICE SANITARY SERVICE TELECOMMUNICASTIONS GAS GAS TELECOMMUNICASTIONS GAS GENERAL SERVICE TELECOMMUNICASTIONS						TIONS E GAS ELECTRICAL	

THE INFORMATION CONTAINED HEREIN IS FOR INTERNAL USE ONLY. NOT TO BE RELIED UPON UNLESS CONFIRMED BY THE SITE INSPECTION AND/OR INVESTIGATION

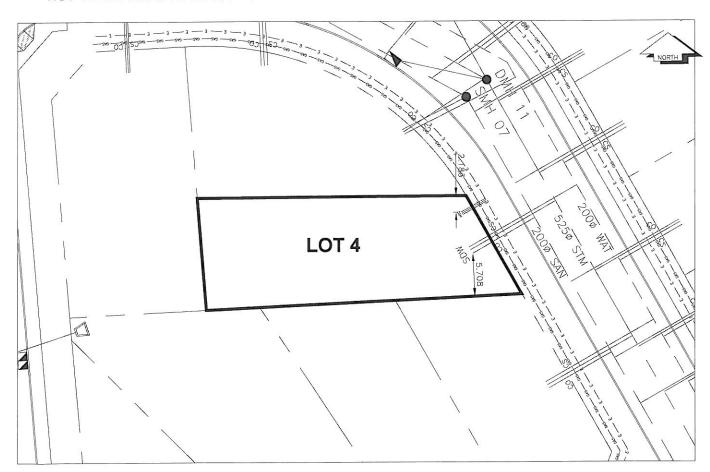

Lot 4

SANITARY, STORM & WATER SERVICE INVERTS	SANITARY	WATER	STORM
1. Distance from San. M.H. 07 toward San. M.H. 08 to lot service connection point is:	18m	N/A	N/A
1a.Distance from Stm. M.H. 11 toward Stm. M.H. 12 to lot service connection point is:	N/A	N/A	19m
2. Main Size at connection point is	200mm	200mm	525mm
3. Invert of main at conn. stub point is	582.38	583.77	582.76
4. Invert at service end is	584.14	584.24	584.21
5. Cut at property line in meters	2.80m	2.78m	2.73m
6. Survey Date: OCT 2009 Book Ref.:1140-07-04 By: FORESIGHT SURVEY & DESIGN			
SANITARY HISTORY:			
Installed By: Fortwood Homes Ltd.			
	e Bross - the composition of the Bross		
WATER HISTORY:			
Installed By: Fortwood Homes Ltd.			
Installed by, Fortwood Horlies Etd.			
	State of the state		
		i i i i i i i i i i i i i i i i i i i	
			
STORM HISTORY:			
Installed By: Fortwood Homes Ltd.			