

City of Prince George

HISTORY SHEET

PID: 028330827

Scale: 1:500

Legal: LOT 11

D.L.: 2014

PLAN: EPP5390

Address: - 7599 Stillwater Crescent

| | | | | | | | |
|-----------------------|-------|--------|-----------|-----|------|--------|-----------|
| Sanitary Connection:# | SIZE: | 100mmØ | MATERIAL: | PVC | INV. | 583.61 | CONNECTED |
|-----------------------|-------|--------|-----------|-----|------|--------|-----------|

| | | | | | | | |
|--------------------|-------|-------|-----------|--------|------|--------|-------|
| Water Connection:# | SIZE: | 19mmØ | MATERIAL: | copper | INV. | 583.54 | METER |
|--------------------|-------|-------|-----------|--------|------|--------|-------|

| | | | | | | | |
|--------------------|------|--------|----------|-----|------|--------|-----------|
| Storm Connection:# | SIZE | 100mmØ | MATERIAL | PVC | INV. | 584.09 | CONNECTED |
|--------------------|------|--------|----------|-----|------|--------|-----------|

| | | | |
|--------------------|-------|----------|-------|
| Cash Receipt No's: | WATER | SANITARY | STORM |
|--------------------|-------|----------|-------|

| | | | |
|-------------------------|----|----------------|-----|
| CURB FROM PROPERTY LINE | 5m | PAVEMENT WIDTH | 10m |
|-------------------------|----|----------------|-----|

| | | | |
|------------|----------|----------------|---|
| B.C. HYDRO | 75mm DB2 | U/G CONNECTION | ✓ |
|------------|----------|----------------|---|

| | | | |
|----------------|----------|----------------|---|
| B.C. TELEPHONE | 50mm DB2 | U/G CONNECTION | ✓ |
|----------------|----------|----------------|---|


| | |
|---------|--------------|
| TERASEN | 42 PROP/P.E. |
|---------|--------------|

Information Sheets: REFERENCE DRAWINGS L&M ENGINEERING LIMITED JOB NO. 1140-07-04

| | | | | |
|-----------|------------------------------|--|--|-------------------|
| Comments: | CS CURB STOP CO CLEAN OUT | SDW WATER SERVICE STORM SERVICE SANITARY SERVICE | TCH HYDRO SERVICE CABLE SERVICE TELECOMMUNICATIONS | GAS ELECTRICAL |
|-----------|------------------------------|--|--|-------------------|

THE INFORMATION CONTAINED HEREIN IS FOR INTERNAL USE ONLY.

NOT TO BE RELIED UPON UNLESS CONFIRMED BY THE SITE INSPECTION AND/OR INVESTIGATION

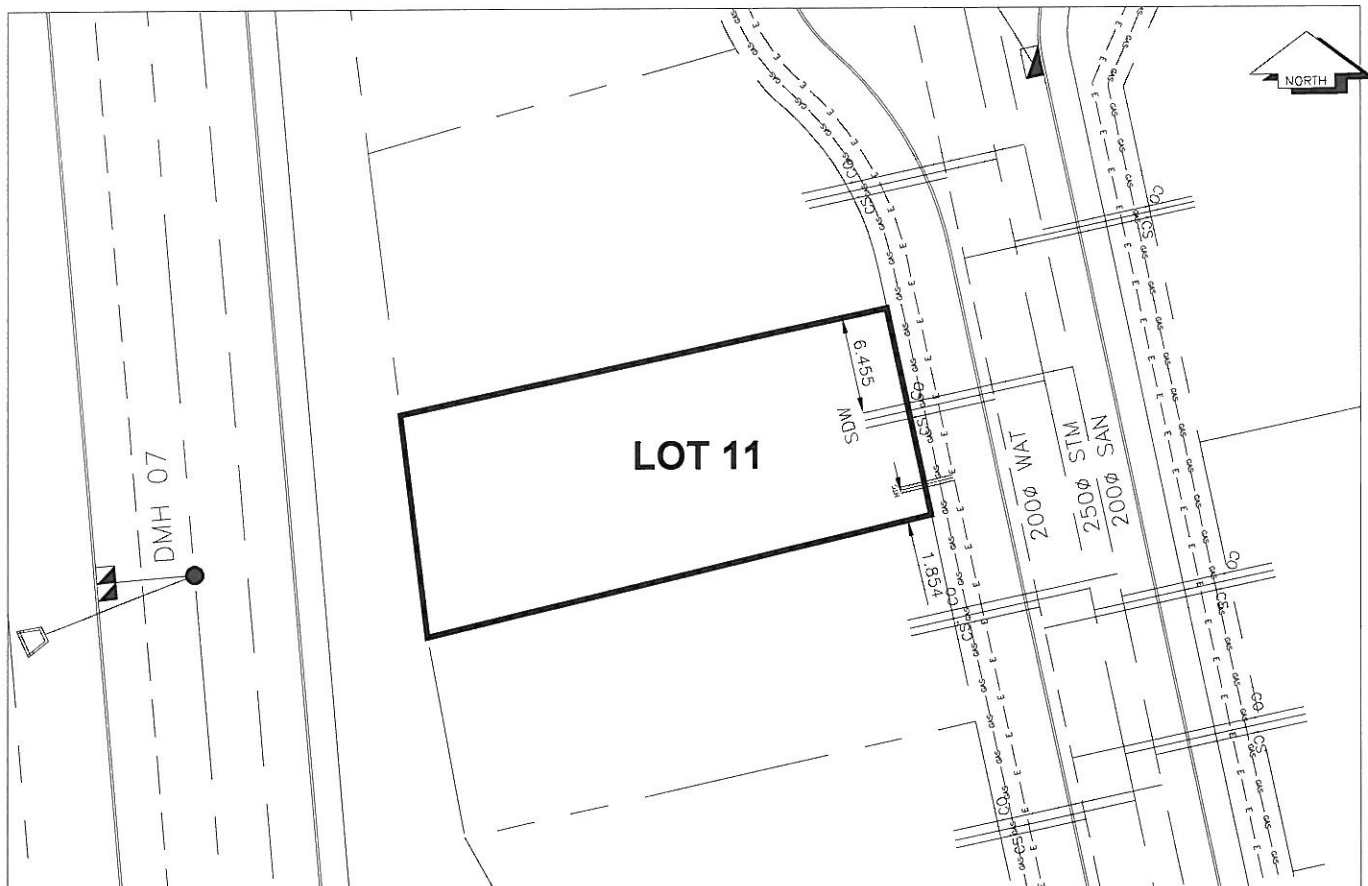

| SANITARY, STORM & WATER SERVICE INVERTS | SANITARY | WATER | STORM |
|---|----------|--------|--------|
| 1. Distance from San. M.H. <u>18</u> toward San. M.H. <u>17</u> to lot service connection point is: | 29m | N/A | N/A |
| 1a.Distance from Stm. M.H. <u>22</u> toward Stm. M.H. <u>21</u> to lot service connection point is: | N/A | N/A | 31m |
| 2. Main Size at connection point is | 200mm | 200mm | 250mm |
| 3. Invert of main at conn. stub point is | 582.92 | 583.04 | 583.57 |
| 4. Invert at service end is | 583.61 | 583.54 | 584.09 |
| 5. Cut at property line in meters | 2.74m | 2.89m | 2.26m |
| 6. Survey Date: OCT 2009 Book Ref.: 1140-07-04 By: FORESIGHT SURVEY & DESIGN | | | |
| | | | |
| | | | |
SANITARY HISTORY:

Installed By: Fortwood Homes Ltd.

WATER HISTORY:

Installed By: Fortwood Homes Ltd.

STORM HISTORY:

Installed By: Fortwood Homes Ltd.