

HISTORY SHEET

PID: 028330951

Scale: 1:500

Legal: LOT 14

D.L.: 2014

PLAN: EPP5390

Address: - 7616 & 7620 Stillwater Crescent

Sanitary Connection:#	SIZE:	100mm 100mmØ	MATERIAL:	PVC PVC	INV.	583.58	CONNECTED
Water Connection:#	SIZE:	19mm 19mmØ	MATERIAL:	copper copper	INV.	583.58	METER
Storm Connection:#	SIZE	100mm 100mmØ	MATERIAL	PVC PVC	INV.	583.99	CONNECTED

Cash Receipt No's:	WATER	SANITARY	STORM
--------------------	-------	----------	-------

CURB FROM PROPERTY LINE	5m	PAVEMENT WIDTH	10m
-------------------------	----	----------------	-----

B.C. HYDRO	75mm DB2	U/G CONNECTION	✓
------------	----------	----------------	---

B.C. TELEPHONE	50mm DB2	U/G CONNECTION	✓
----------------	----------	----------------	---


TERASEN 42 PROP/P.E.

Information Sheets: REFERENCE DRAWINGS L&M ENGINEERING LIMITED JOB NO. 1140-07-04

Comments:	CS	CURB STOP	SDW	WATER SERVICE STORM SERVICE SANITARY SERVICE	TCH	HYDRO SERVICE CABLE SERVICE TELECOMMUNICATIONS	GAS ELECTRICAL
	CO	CLEAN OUT					

THE INFORMATION CONTAINED HEREIN IS FOR INTERNAL USE ONLY.

NOT TO BE RELIED UPON UNLESS CONFIRMED BY THE SITE INSPECTION AND/OR INVESTIGATION

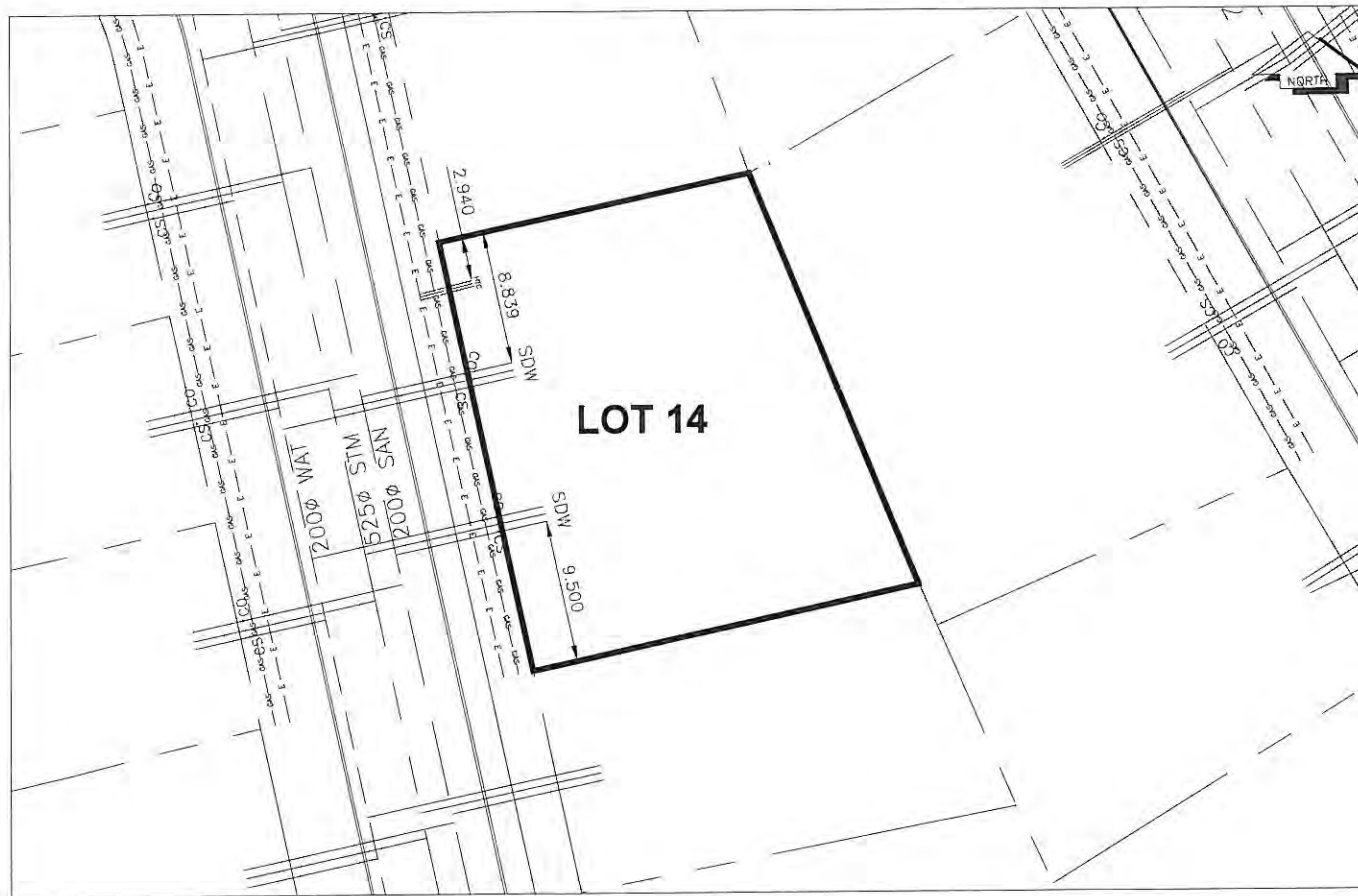

SANITARY, STORM & WATER SERVICE INVERTS NORTH	SANITARY	WATER	STORM
1. Distance from San. M.H. <u>18</u> toward San. M.H. <u>17</u> to lot service connection point is:	45m	N/A	N/A
1a. Distance from Stm. M.H. <u>22</u> toward Stm. M.H. <u>11</u> to lot service connection point is:	N/A	N/A	47m
2. Main Size at connection point is	200mmØ	200mmØ	250mmØ
3. Invert of main at conn. stub point is	582.98	582.89	583.42
4. Invert at service end is	583.58	583.58	583.99
5. Cut at property line in meters	2.66m	2.74m	2.25m
6. Survey Date: OCT 2009 Book Ref.: 1140-07-04 By: FORESIGHT SURVEY & DESIGN			
SANITARY, STORM & WATER SERVICE INVERTS SOUTH	SANITARY	WATER	STORM
1. Distance from San. M.H. <u>18</u> toward San. M.H. <u>17</u> to lot service connection point is:	55m	N/A	N/A
1a. Distance from Stm. M.H. <u>22</u> toward Stm. M.H. <u>21</u> to lot service connection point is:	N/A	N/A	56m
2. Main Size at connection point is	200mmØ	200mmØ	250mmØ
3. Invert of main at conn. stub point is	582.90	582.95	583.48
4. Invert at service end is	583.54	583.74	584.00
5. Cut at property line in meters	2.65m	2.74m	2.19m
6. Survey Date: OCT 2009 Book Ref.: 1140-07-04 By: FORESIGHT SURVEY & DESIGN			

SANITARY HISTORY:

Installed By: Fortwood Homes Ltd.

WATER HISTORY:

Installed By: Fortwood Homes Ltd.

STORM HISTORY:

Installed By: Fortwood Homes Ltd.