
City of Prince George HISTORY SHEET

01				Sc	ale: 1:500				
			B	D.I	L.: 2 014		PLAN:	EPP5390	
eekside V	Vay								
	SIZE:	100mmØ	MATERIAL:	PVC	INV.	583.37	CONNE	ECTED	
_	SIZE:	19mmØ	MATERIAL:	copper	INV.	583.55	METER	l	
	SIZE	100mmØ	MATERIAL	PVC	INV.	583.35	CONNE	ECTED	
Cash Receipt No's:		WATER		SANITARY			STORM		
RTY LINE	5m	· · · · · · · · · · · · · · · · · · ·				PAVEM	ENT WIDTH	10m	
75mm DB2				U/G CONNECT	TION	<u> </u>			
50mm DB2		THE STATE OF THE S	20.44	U/G CONNECTION					
42 PROP/P	P.E.							1000	
		GS L&M ENGIN							
cs cu	URB STOP LEAN OUT	<u> </u>	STORM SERVICE SANITARY SERV	ICE =	HYDRO	SERVICE SERVICE DMMUNICAS	STIONS - CAS-	GAS ELECTRICAL	
	75mm DB2 50mm DB2 42 PROP/F REFERENCE	reekside Way SIZE: SIZE: SIZE RTY LINE 5m 75mm DB2 50mm DB2 42 PROP/P.E. REFERENCE DRAWING CS, CURB STOP	SIZE: 100mmØ SIZE: 19mmØ SIZE 100mmØ WATER RTY LINE 5m 75mm DB2 50mm DB2 42 PROP/P.E. REFERENCE DRAWINGS L&M ENGIN	SIZE: 100mmØ MATERIAL: SIZE: 19mmØ MATERIAL: SIZE 100mmØ MATERIAL WATER RTY LINE 5m 75mm DB2 50mm DB2 42 PROP/P.E. REFERENCE DRAWINGS L&M ENGINEERING LIMITE	D. Teekside Way SIZE: 100mmØ MATERIAL: PVC SIZE: 19mmØ MATERIAL: copper SIZE 100mmØ MATERIAL PVC WATER SANITARY RTY LINE 5m 75mm DB2 U/G CONNEC 50mm DB2 U/G CONNEC 42 PROP/P.E. REFERENCE DRAWINGS L&M ENGINEERING LIMITED JOB NO. 11	D.L.: 2014 reekside Way SIZE: 100mmØ MATERIAL: PVC INV. SIZE: 19mmØ MATERIAL: copper INV. SIZE 100mmØ MATERIAL PVC INV. WATER SANITARY RTY LINE 5m 75mm DB2 U/G CONNECTION 42 PROP/P.E. REFERENCE DRAWINGS L&M ENGINEERING LIMITED JOB NO. 1140-07-04	D.L.: 2014	D.L.: 2014 PLAN: D.L.: 2014 PLAN: PERENSIDE WAY SIZE: 100mmØ MATERIAL: PVC INV. 583.37 CONNE SIZE: 19mmØ MATERIAL: copper INV. 583.55 METER SIZE 100mmØ MATERIAL PVC INV. 583.35 CONNE WATER SANITARY STORM RTY LINE 5m PAVEMENT WIDTH 75mm DB2 U/G CONNECTION 42 PROP/P.E. REFERENCE DRAWINGS L&M ENGINEERING LIMITED JOB NO. 1140-07-04	

THE INFORMATION CONTAINED HEREIN IS FOR INTERNAL USE ONLY. NOT TO BE RELIED UPON UNLESS CONFIRMED BY THE SITE INSPECTION AND/OR INVESTIGATION

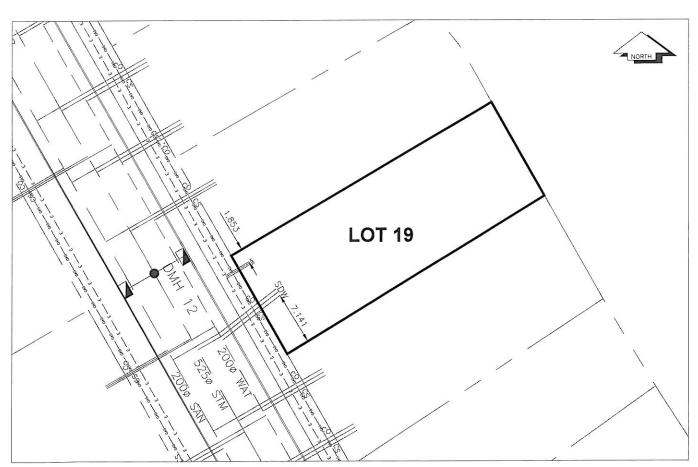

	CANITADY	MATED	Lot 19
SANITARY, STORM & WATER SERVICE INVERTS	SANITARY	WATER	STORM
1. Distance from San. M.H. <u>08</u> toward San. M.H. <u>09</u> to lot service connection point is:	54m	N/A	N/A
1a.Distance from Stm. M.H. 12 toward Stm. M.H. 13 to lot service connection point is:	N/A	N/A	12m
2. Main Size at connection point is	200mm	200mm	525mm
3. Invert of main at conn. stub point is	582.60	582.25	582.05
4. Invert at service end is	583.37	583,55	583,35
5. Cut at property line in meters	2.80m	2.70m	2.82m
6. Survey Date: OCT 2009 Book Ref.:1140-07-04 By: FORESIGHT SURVEY & DESIGN			
SANITARY HISTORY:			
Installed By: Fortwood Homes Ltd.			
WATER HISTORY:			
Installed By: Fortwood Homes Ltd.			
STORM HISTORY:			
Installed By: Fortwood Homes Ltd.			
	2-11-11		
- 711 - 721 -			