
City of Prince George HISTORY SHEET

PID: .02833101	1O Scale: 1:500							
Legal: LOT 20				D.L	: 2014		PLAN: EPP5390	
	reekside Way							
Sanitary Connection:#	SIZE:	100mmØ	MATERIAL:	PVC	INV.	583.28	CONNECTED	
Water Connection:#	SIZE:	19mmØ	MATERIAL:	copper	INV.	583.24	METER	
Storm Connection:#	SIZE	100mmØ	MATERIAL	PVC	INV.	583.24	CONNECTED	
Cash Receipt No's:		WATER		SANITARY			STORM	
CURB FROM PROPER					PAVEME	NT WIDTH 10m		
B.C. HYDRO	TY LINE 5m 75mm DB2			U/G CONNECT	ION	/		
B.C. TELEPHONE	50mm DB2			U/G CONNECTION				
TERASEN	42 PROP/P.E.							
Information Sheets:	REFERENCE DRAWINGS L&M ENGINEERING LIMITED JOB NO. 1140-07-04							
Comments:	CS CURB STOP CO CLEAN OUT WATER SERVICE STORM SERVICE SANITARY SERVICE							

THE INFORMATION CONTAINED HEREIN IS FOR INTERNAL USE ONLY.
NOT TO BE RELIED UPON UNLESS CONFIRMED BY THE SITE INSPECTION AND/OR INVESTIGATION

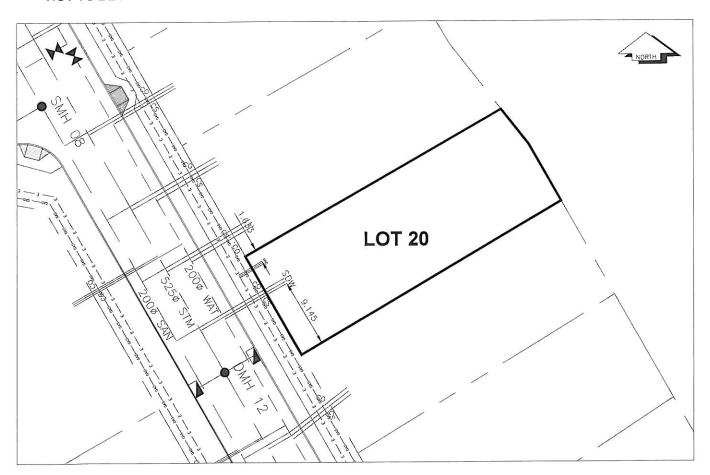

SANITARY, STORM & WATER SERVICE INVERTS	SANITARY	WATER	STORM			
1. Distance from San. M.H. 08 toward San. M.H. 09 to lot service connection point is:	36m	N/A	N/A			
1a.Distance from Stm. M.H. 11 toward Stm. M.H. 12 to lot service connection point is:	N/A	N/A	110m			
2. Main Size at connection point is	200mm	200mm	525mm			
3. Invert of main at conn. stub point is	582.54	582.59	582.21			
4. Invert at service end is	583,28	583.24	583.24			
5. Cut at property line in meters	3.07m	3.19m	3.11m			
6. Survey Date: OCT 2009 Book Ref.:1140-07-04 By: FORESIGHT SURVEY & DESIGN						
		466				
SANITARY HISTORY:						
Installed By: Fortwood Homes Ltd.						
WATER HISTORY:						
Installed By: Fortwood Homes Ltd.						
STORM HISTORY:						
Installed By: Fortwood Homes Ltd.						
		_				