

# City of Prince George

## HISTORY SHEET

PID: 028331061

Scale: 1:500

Legal: LOT 25

D.L.: 2014

PLAN: EPP5390

Address: - 7480 Creekside Way

Sanitary Connection:#	SIZE:	100mmØ	MATERIAL:	PVC	INV.	583.90	CONNECTED
-----------------------	-------	--------	-----------	-----	------	--------	-----------

Water Connection:#	SIZE:	19mmØ	MATERIAL:	copper	INV.	583.90	METER
--------------------	-------	-------	-----------	--------	------	--------	-------

Storm Connection:#	SIZE:	100mmØ	MATERIAL:	PVC	INV.	583.88	CONNECTED
--------------------	-------	--------	-----------	-----	------	--------	-----------

Cash Receipt No's:	WATER	SANITARY	STORM
--------------------	-------	----------	-------

CURB FROM PROPERTY LINE	5m	PAVEMENT WIDTH	10m
-------------------------	----	----------------	-----

B.C. HYDRO	75mm DB2	U/G CONNECTION	✓
------------	----------	----------------	---


B.C. TELEPHONE	50mm DB2	U/G CONNECTION	✓
----------------	----------	----------------	---

TERASEN	42 PROP/P.E.
---------	--------------

Information Sheets: REFERENCE DRAWINGS L&M ENGINEERING LIMITED JOB NO. 1140-07-04

Comments:	CS CURB STOP	SDW WATER SERVICE	TCH HYDRO SERVICE	GAS GAS
	CO CLEAN OUT	SDW STORM SERVICE	TCH CABLE SERVICE	E ELECTRICAL
		SDW SANITARY SERVICE	TCH TELECOMMUNICATIONS	

**THE INFORMATION CONTAINED HEREIN IS FOR INTERNAL USE ONLY.**  
**NOT TO BE RELIED UPON UNLESS CONFIRMED BY THE SITE INSPECTION AND/OR INVESTIGATION**

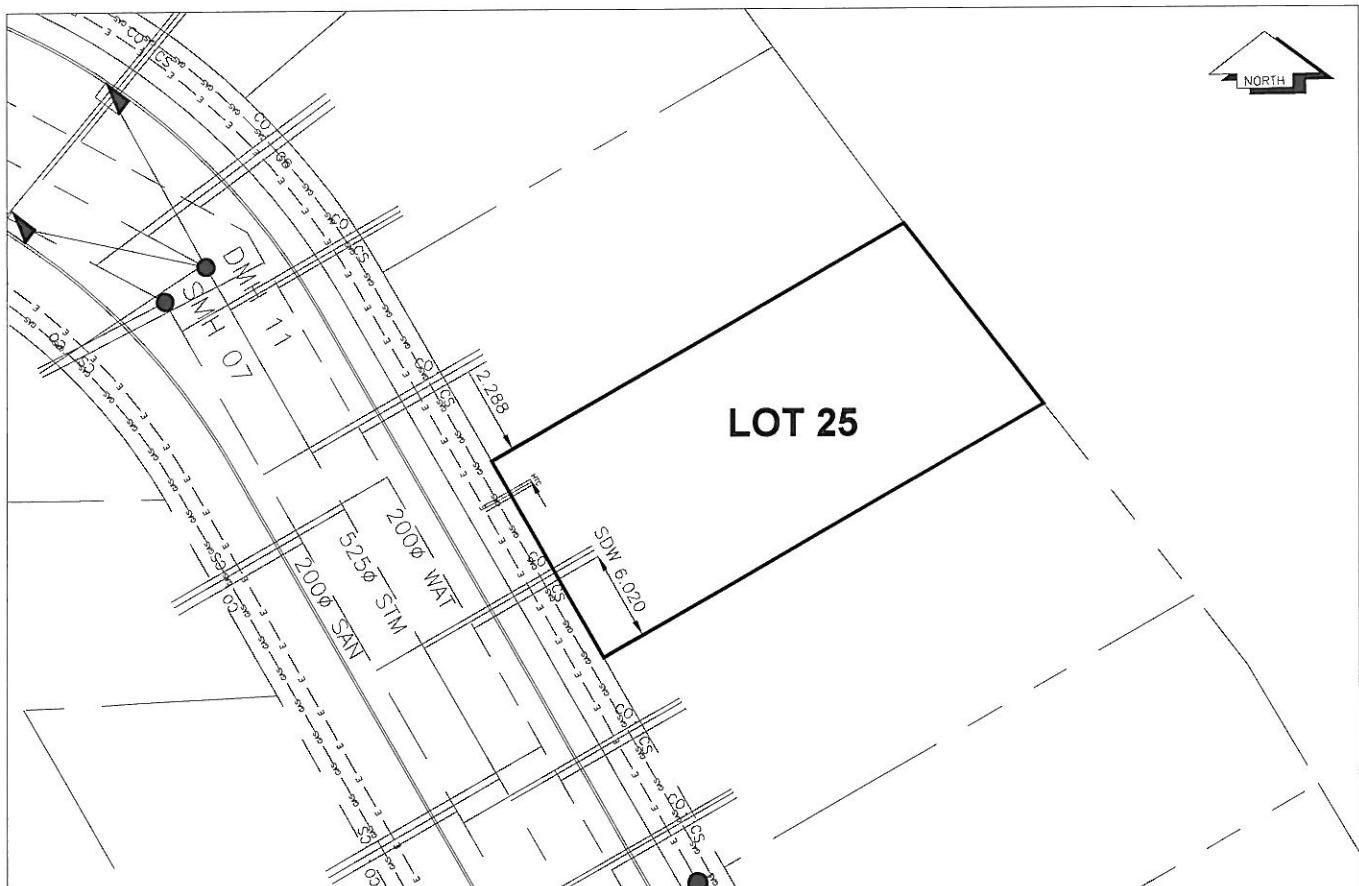

Installed By: Fortwood Homes Ltd.

Installed By: Fortwood Homes Ltd.

Installed By: Fortwood Homes Ltd.