



City of Prince George
History Sheet

PID:	028341911
MU:	101105
WO:	54604/54605

Civic Address: 1345, 1373 6th Ave
1302, 1364 7th Ave
605 Quebec St

Legal Description: Parcel 1 District Lot: 343 Plan: BCP29643 except Air Space Plan BCP45794


Service Type	Diameter (mm)	Material	Invert Elev at main (m)	Invert Elev at property line (m)	Invert Elev at service end (m)	Distance into property (m)	Installation Date
Sanitary - S1	150mm	PVC	568.06	568.11	-	-	August 2010
Sanitary - S2	200mm	PVC	568.22	568.41	-	-	August 2010
Sanitary - S3	200mm	PVC	569.40	569.83	-	-	August 2010
Sanitary - S4	200mm	PVC	-	-	-	-	August 2010
Water - W1	100mm	PVC	-	-	-	-	May 2009
Water - W2	200mm	PVC	-	-	-	-	August 2010
Water - W3	200mm	PVC	-	-	-	-	August 2010
Storm - D1	300mm	PVC	568.20	-	-	-	July 2009
Storm - D2	150mm	PVC	568.22	-	-	-	January 1972
Storm - D3	200mm	PVC	567.76	-	-	-	January 1972

Service Connection Location	Sanitary (m)	Storm (m)
150mm Sanitary service connected to San MH 3115	-	
200mm SE Sanitary service connected to San MH 5154		
200mm MW Sanitary service connected to new San MH		
250mm D1 Storm service connected to Stm MH 3579		
Distance from downstream Stm MH 1061 towards upstream Stm MH 1021	10.10	
150mm d3 Storm Service connected to Stm MH 3398		

Power	Size	Communications	Size	Cable	Size	Gas	Size
BC Hydro	-	Telus	-	Shaw	-	FortisBC	-
Underground Service		Underground Service		Underground Service			

Installed by: City of Prince George forces	Survey Date: -
Comments:	

NOT TO SCALE The information contained herein is for internal use only.
Not to be relied on unless confirmed by site inspection and/or investigation.

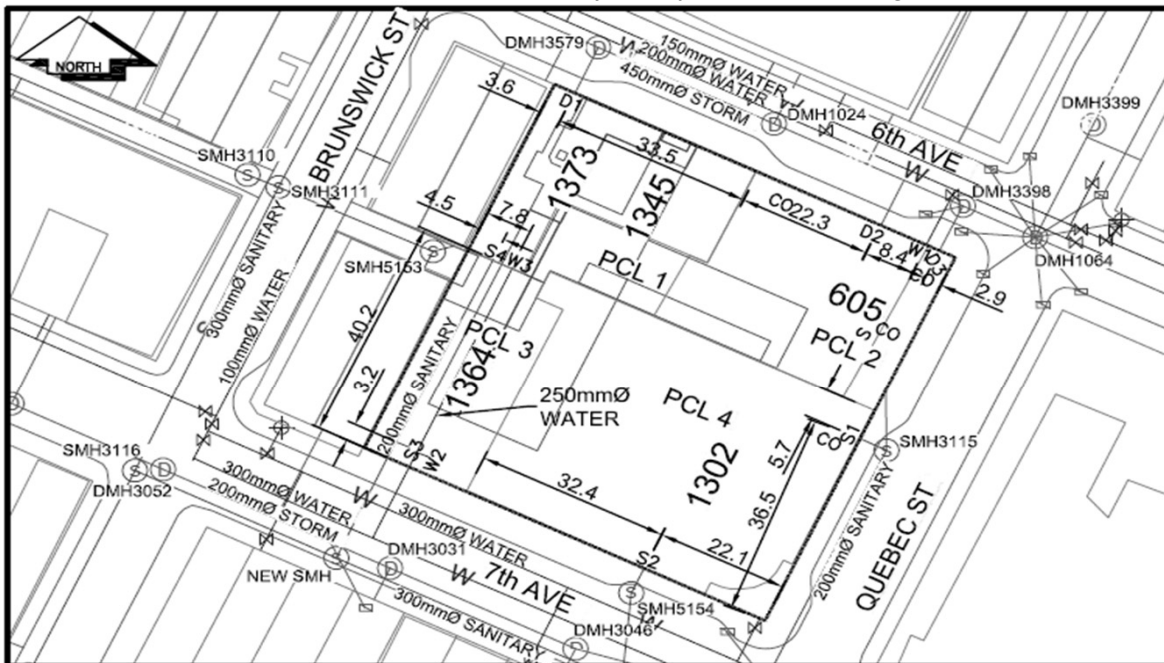

CS ^o CURB STOP	—W— WATER SERVICE	—S— STORM SERVICE
CO ^o CLEAN OUT	- - - - - SANITARY SERVICE	—G— GAS
⊗ WATER VALVE	⊗ FIRE HYDRANT	- - - - - ENCUMBRANCE

NOT TO SCALE