



City of Prince George History Sheet

PID:	028345479
SD/MU:	
WO:	

Civic Address: 3450 15th Ave
1475 Ahbau St

Legal Description: Lot: Parcel B (CA1756900) District Lot: 936 Plan: 15185


Service Type	Diameter (mm)	Material	Invert Elev at main (m)	Invert Elev at property line (m)	Invert Depth at service end (m)	Distance into property (m)	Installation Date
Sanitary	150mm	AC	-	-	1.68	-	December 1962
Water	100mm	CI	-	-	-	-	December 1962
Storm	200mm	AC	-	-	1.83	-	December 1965

Service Connection Location				Sanitary (m)	Storm (m)
Distance from downstream San MH	838	towards upstream San MH	719	25.41	
200mm Storm service connects to Stm MH3163					

Power	Size	Communications	Size	Cable	Size	Gas	Size
BC Hydro	-	Telus	-	Shaw	-	FortisBC	-
Overhead Service		Overhead Service		Overhead Service			

Installed by:	Survey Date:	-
Comments:		

NOT TO SCALE The information contained herein is for internal use only.
Not to be relied on unless confirmed by site inspection and/or investigation.

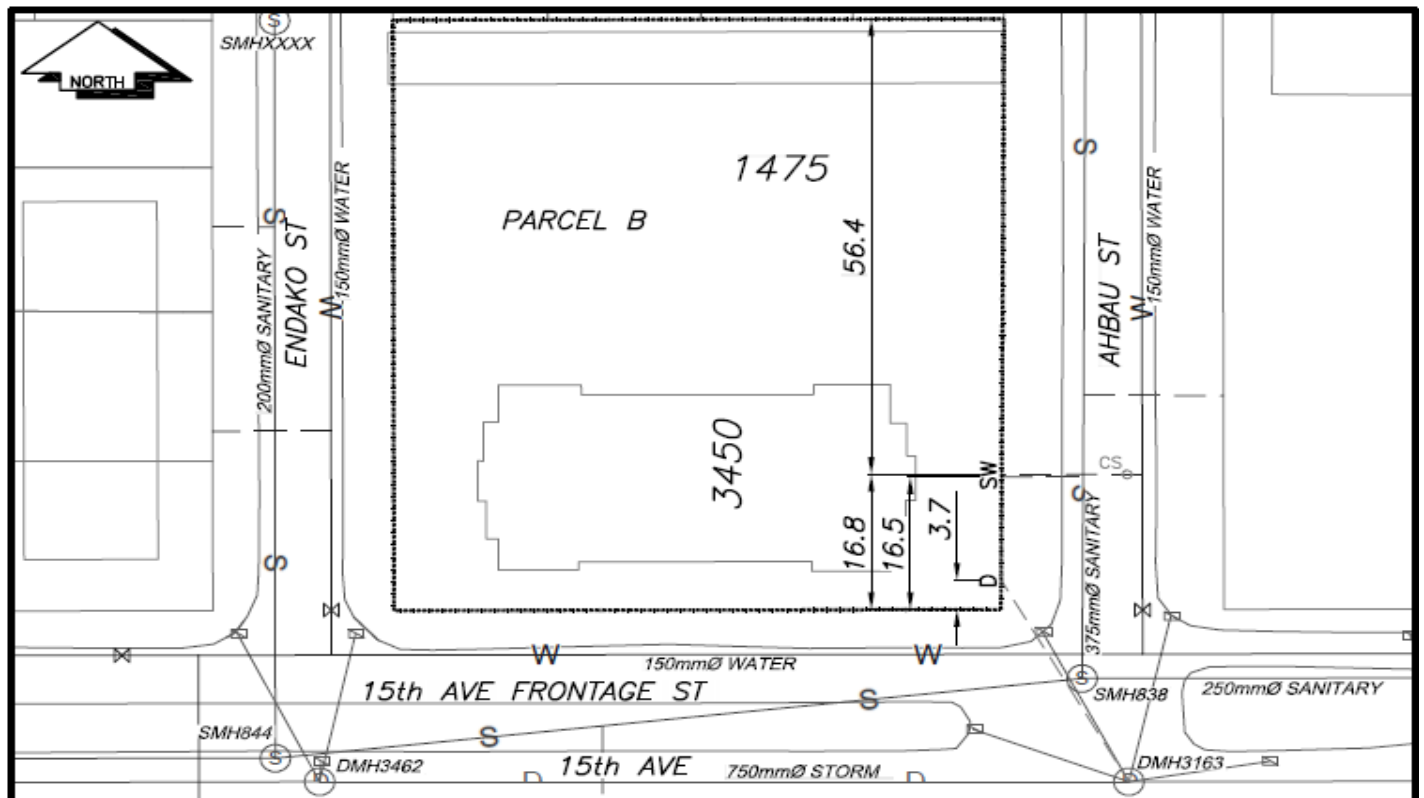

CS	CURB STOP	W	WATER SERVICE	S	STORM SERVICE
CO	CLEAN OUT	- - - - -	SANITARY SERVICE	G	GAS
X	WATER VALVE	⊗	FIRE HYDRANT	- - - - -	ENCUMBRANCE

NOT TO SCALE