



City of Prince George  
**History Sheet**

PID:	028346157
MU:	101130
WO:	55294/55295

Civic Address: 3038 Hawke Rd

Legal Description: Lot: PCL G Block: 13 (BB1284375) District Lot: 629 Plan: 902


Service Type	Diameter (mm)	Material	Invert Elev at main (m)	Invert Elev at property line (m)	Invert Elev at service end (m)	Distance into property (m)	Installation Date
Sanitary	100mm	PVC	-	-	-	3.00	October 2015
Water	20mm	Copper	-	-	-	3.00	October 2015
Storm	N/A	N/A	-	-	-	-	

Service Connection Location				Sanitary (m)	Storm (m)
Distance from downstream San MH	3218	towards upstream San MH	3219	39.66	
Distance from downstream Stm MH	-	towards upstream Stm MH	-		

Power	Size	Communications	Size	Cable	Size	Gas	Size
BC Hydro	-	Telus	-	Shaw	-	FortisBC	-
Overhead Service		Overhead Service		Overhead Service			

Installed by:	City of Prince George forces	Survey Date:	-
Comments:			

**NOT TO SCALE** The information contained herein is for internal use only.  
Not to be relied on unless confirmed by site inspection and/or investigation.

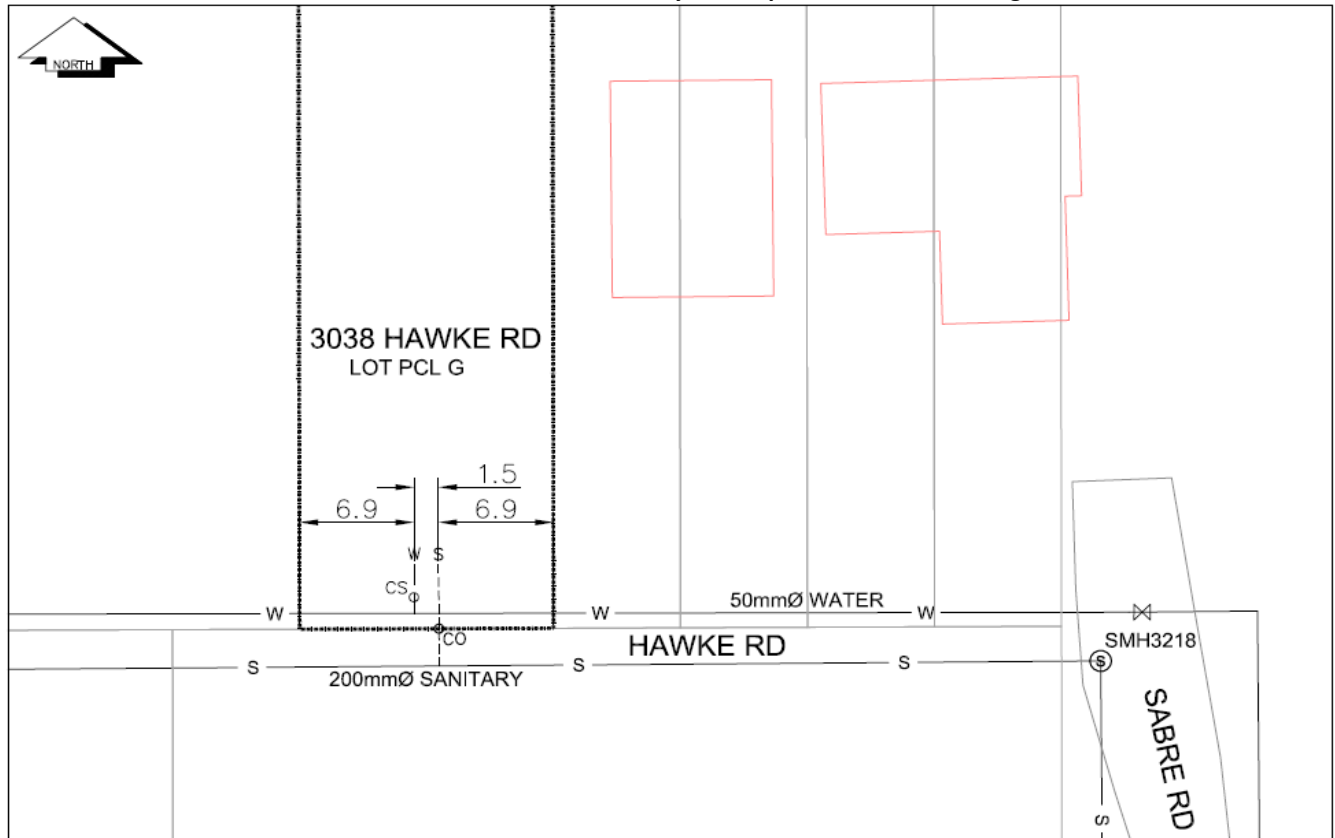

LEGEND:	CS <sup>o</sup> CURB STOP	--- W WATER SERVICE	--- S SANITARY SERVICE	--- D STORM SERVICE	⊗ WATER VALVE
	CO <sup>o</sup> CLEAN OUT				

**NOT TO SCALE**