



# City of Prince George History Sheet

PID:	028350944
MU:	101355
WO:	

Civic Address: 7677 Pacific St

Legal Description: Lot: REM 1 & DL 750, EXCEPT PL EPP26908 District Lot: 749 Plan: EPP9173


Service Type	Diameter (mm)	Material	Invert Elev at main (m)	Invert Elev at property line (m)	Invert Elev at service end (m)	Distance into property (m)	Installation Date
Sanitary	150mm	PVC	-	-	-	-	-
Water	40mm	Copper	-	-	-	-	-
Storm	N/A	N/A	-	-	-	-	-

Service Connection Location	Sanitary (m)	Storm (m)
150mm Sanitary service connected to new SMH on Pacific St	-	
Distance from downstream Stm MH - towards upstream Stm MH		-

Power	Size	Communications	Size	Cable	Size	Gas	Size
BC Hydro	-	Telus	-	Shaw	-	FortisBC	-
Overhead Service		Overhead Service		Overhead Service			

Installed by:	City of Prince George forces	Survey Date:	-
Comments:			

**NOT TO SCALE** The information contained herein is for internal use only.  
Not to be relied on unless confirmed by site inspection and/or investigation.

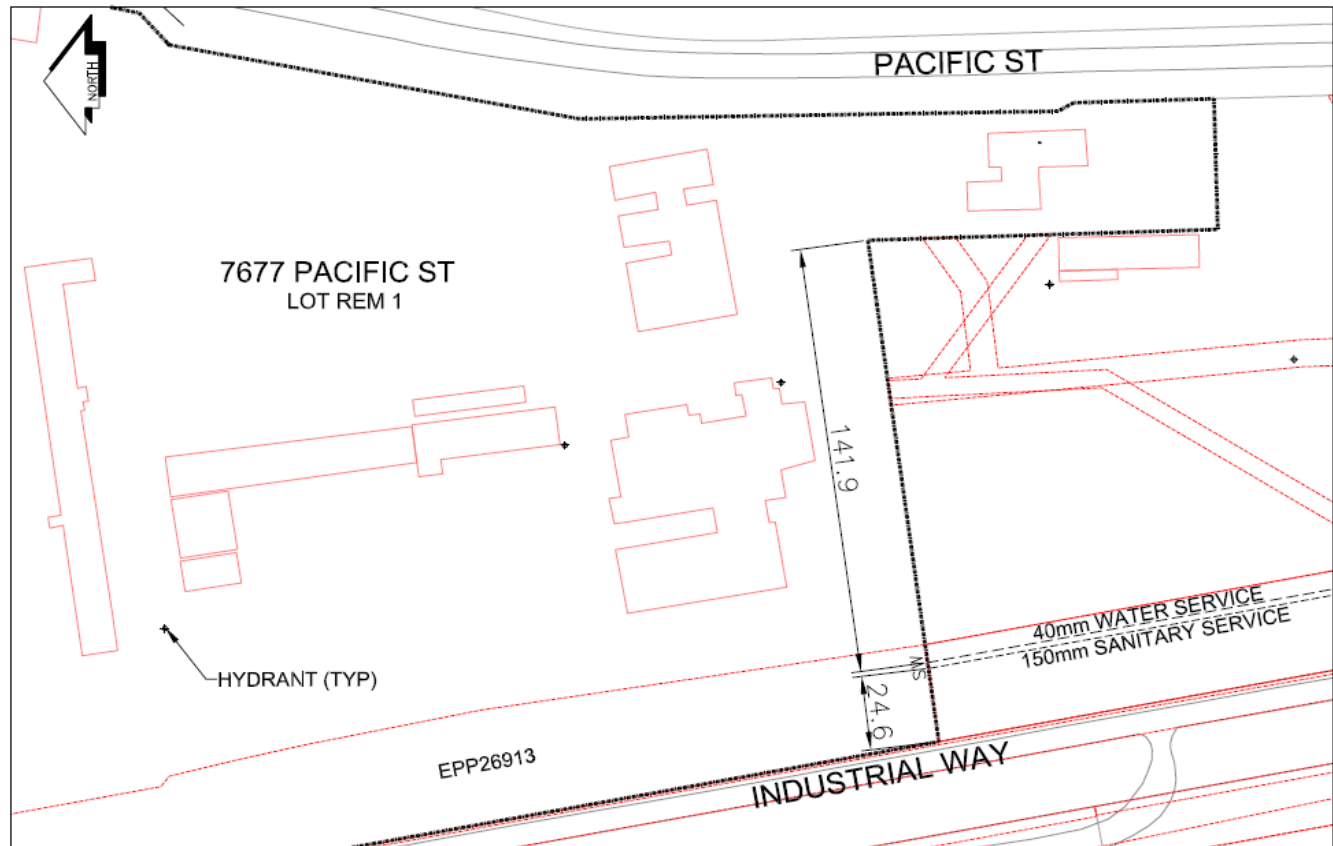

CS <sup>o</sup>	CURB STOP	---	WATER SERVICE	---	STORM SERVICE
CO <sup>o</sup>	CLEAN OUT	---	SANITARY SERVICE	---	WATER VALVE

**NOT TO SCALE**