

City of Prince George

HISTORY SHEET

PID: 028353536

Scale: 1:500

Legal: LOT 23

D.L.: 2003

PLAN: BCP46243

Address: 4583 MAURICE DR

Sanitary Connection:# SIZE: 100mmØ MATERIAL: PVC INV. 712.45 CONNECTED

Water Connection:# SIZE: 19mmØ MATERIAL: Copper INV. 712.45

Storm Connection:# SIZE: 100mmØ MATERIAL: PVC INV. 712.45 CONNECTED

Cash Receipt No's: WATER SANITARY STORM

CURB FROM PROPERTY LINE 5m PAVEMENT WIDTH 10m

HYDRO 75mm DB2 U/G CONNECTION ✓

TELEPHONE 100mm DB2 U/G CONNECTION ✓


GAS 42 PROP/P.E.

Information Sheets: REF. DWGS. L&M ENGINEERING LTD. JOB. 1273-05-04 DWGS. (001-307)

Comments: CS CURB STOP CO CLEAN OUT SDW WATER SERVICE STORM SERVICE SANITARY SERVICE HTC HYDRO SERVICE CABLE SERVICE TELECOMMUNICATIONS GAS GAS ELECTRICAL

THE INFORMATION CONTAINED HEREIN IS FOR INTERNAL USE ONLY.

NOT TO BE RELIED UPON UNLESS CONFIRMED BY THE SITE INSPECTION AND/OR INVESTIGATION

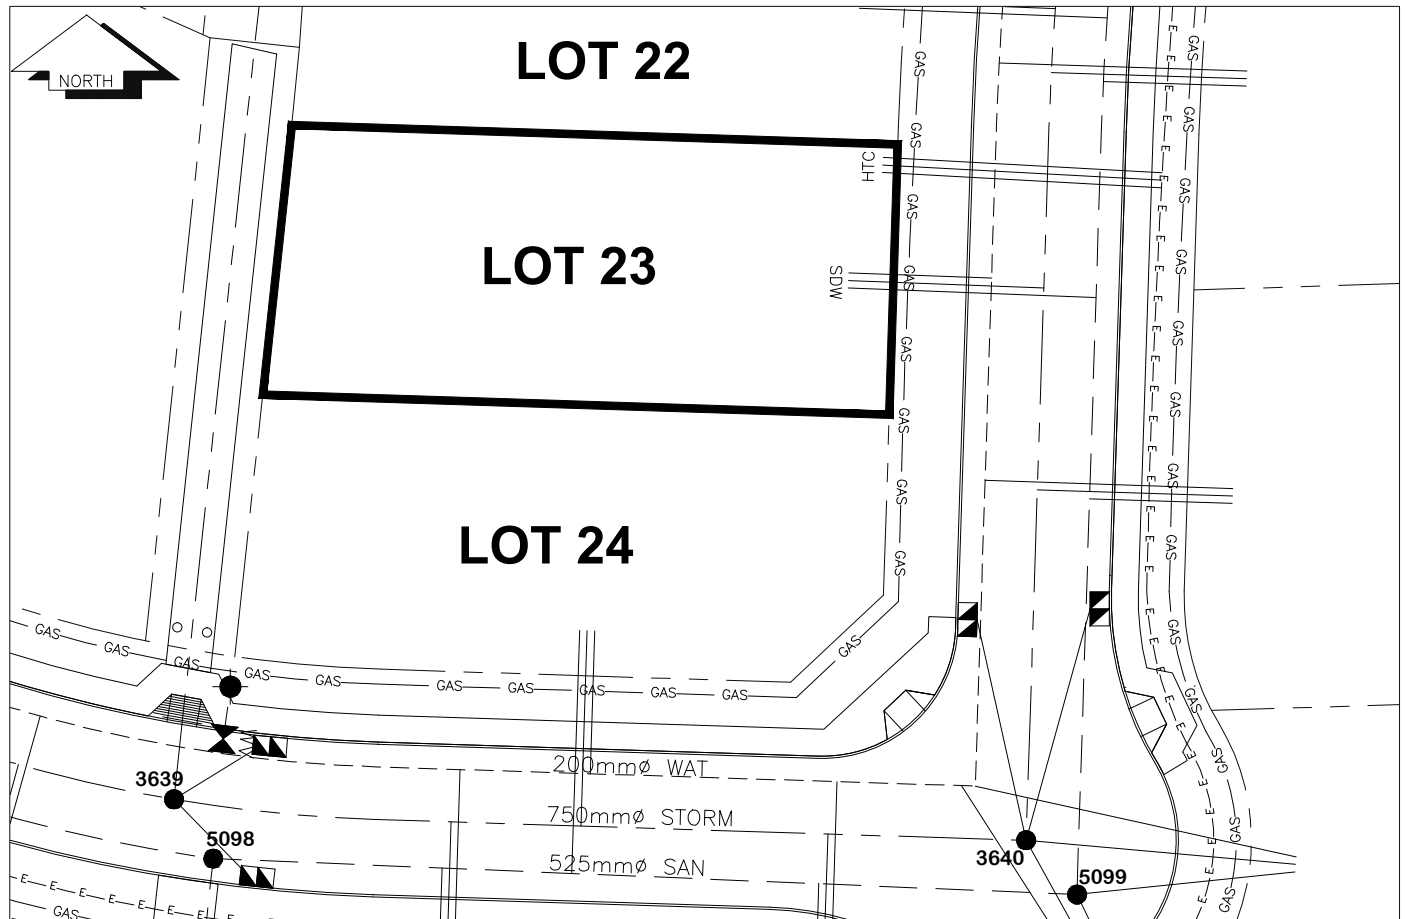

SANITARY, STORM & WATER SERVICE INVERTS	SANITARY	WATER	STORM
1. Distance from San. M.H. <u>5099</u> toward San. M.H. <u>-</u> to lot service connection point is:	40m	N/A	N/A
1a.Distance from Stm. M.H. <u>3640</u> toward Stm. M.H. <u>-</u> to lot service connection point is:	N/A	N/A	37m
2. Main Size at connection point is	525mmØ	200mmØ	750mmØ
3. Invert of main at conn. stub point is	710.11	711.14	709.67
4. Invert at service end is	712.67	712.57	712.57
5. Cover at property line in meters	2.23m	2.31m	2.23m
6. Survey Date: MAY 2010 Book Ref.: 1273-05-03 By: PIERRE DORION			

SANITARY HISTORY:

DATE INSTALLED: JUNE 2010

INSTALLED BY: PROGRESSIVE CONTRACTORS LTD.

WATER HISTORY:

DATE INSTALLED: JUNE 2010

INSTALLED BY: PROGRESSIVE CONTRACTORS LTD.

STORM HISTORY:

DATE INSTALLED: JUNE 2010

INSTALLED BY: PROGRESSIVE CONTRACTORS LTD.
