

City of Prince George

HISTORY SHEET

PID: 028353731

Scale: 1:500

Legal: LOT 42

D.L.: 1600, 2003

PLAN: BCP46243

Address: 2508 MAURICE DR


Sanitary Connection:#	SIZE: 100mmØ	MATERIAL: PVC	INV. 720.49	CONNECTED
Water Connection:#	SIZE: 19mmØ	MATERIAL: Copper	INV. 720.24	
Storm Connection:#	SIZE: 100mmØ	MATERIAL: PVC	INV. 720.24	CONNECTED
Cash Receipt No's:	WATER	SANITARY	STORM	
CURB FROM PROPERTY LINE	5m	PAVEMENT WIDTH	10m	
HYDRO	75mm DB2	U/G CONNECTION	✓	
TELEPHONE	100mm DB2	U/G CONNECTION	✓	
GAS	42 PROP/P.E.			

Information Sheets: REF. DWGS. L&M ENGINEERING LTD. JOB. 1273-05-04 DWGS. (001-307)

Comments: CS CURB STOP CO CLEAN OUT SDW WATER SERVICE STORM SERVICE SANITARY SERVICE TCH HYDRO SERVICE CABLE SERVICE TELECOMMUNICATIONS GAS GAS ELECTRICAL

THE INFORMATION CONTAINED HEREIN IS FOR INTERNAL USE ONLY.

NOT TO BE RELIED UPON UNLESS CONFIRMED BY THE SITE INSPECTION AND/OR INVESTIGATION

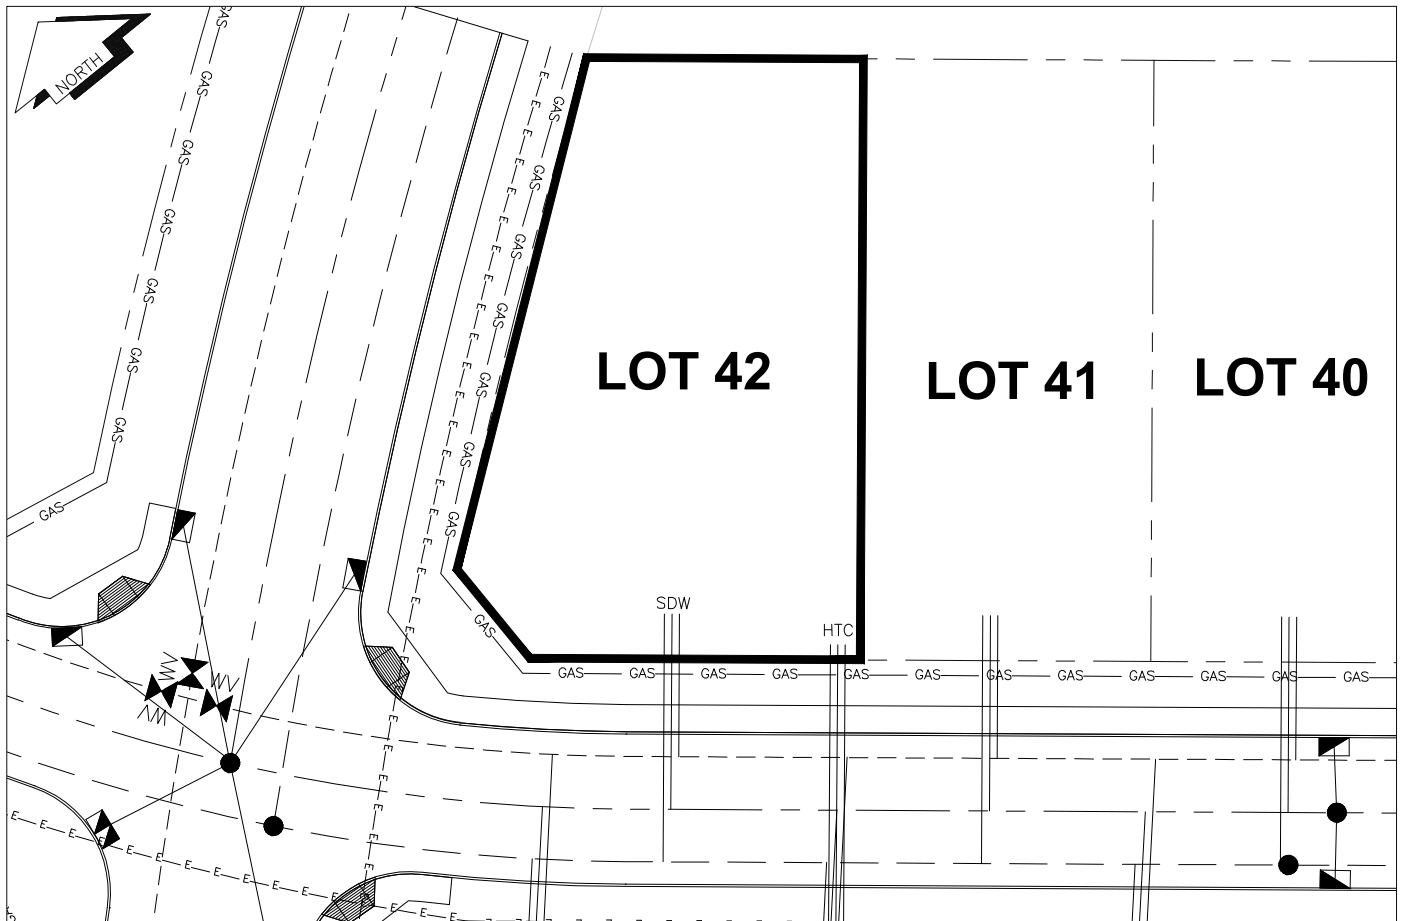

SANITARY, STORM & WATER SERVICE INVERTS	SANITARY	WATER	STORM
1. Distance from San. M.H. <u>5092</u> toward San. M.H. <u>5093</u> to lot service connection point is:	26m	N/A	N/A
1a.Distance from Stm. M.H. <u>3633</u> toward Stm. M.H. <u>3634</u> to lot service connection point is:	N/A	N/A	30m
2. Main Size at connection point is	200mmØ	200mmØ	375mmØ
3. Invert of main at conn. stub point is	720.05	719.17	719.59
4. Invert at service end is	720.57	720.34	720.34
5. Cover at property line in meters	2.26m	2.59m	2.51m
6. Survey Date: MAY 2010 Book Ref.: 1273-05-03 By: PIERRE DORION			

SANITARY HISTORY:

DATE INSTALLED: JUNE 2010

INSTALLED BY: PROGRESSIVE CONTRACTORS LTD.

WATER HISTORY:

DATE INSTALLED: JUNE 2010

INSTALLED BY: PROGRESSIVE CONTRACTORS LTD.

STORM HISTORY:

DATE INSTALLED: JUNE 2010

INSTALLED BY: PROGRESSIVE CONTRACTORS LTD.
