



City of Prince George History Sheet

PID:	028365241
MU:	101096
WO:	54617/54618

Civic Address: 6502 Dawson Rd

Legal Description: Lot: 3 District Lot: 4028 Plan: EPP8191


Service Type	Diameter (mm)	Material	Invert Elev at main (m)	Invert Elev at property line (m)	Invert Elev at service end (m)	Distance into property (m)	Installation Date
Sanitary	100mm	PVC	-	-	-	3.00	June 2011
Water	20mm	Copper	-	-	-	3.00	June 2011
Storm	N/A	N/A	-	-	-	-	

Service Connection Location				Sanitary (m)	Storm (m)
Distance from downstream San MH	409	towards upstream San MH	404	54.40	
Distance from downstream Stm MH	-	towards upstream Stm MH	-		

Power	Size	Communications	Size	Cable	Size	Gas	Size
BC Hydro	-	Telus	-	Shaw	-	FortisBC	-
Underground Service		Underground Service		Underground Service			

Installed by:	City of Prince George forces	Survey Date:	-
Comments:			

NOT TO SCALE The information contained herein is for internal use only.
Not to be relied on unless confirmed by site inspection and/or investigation.

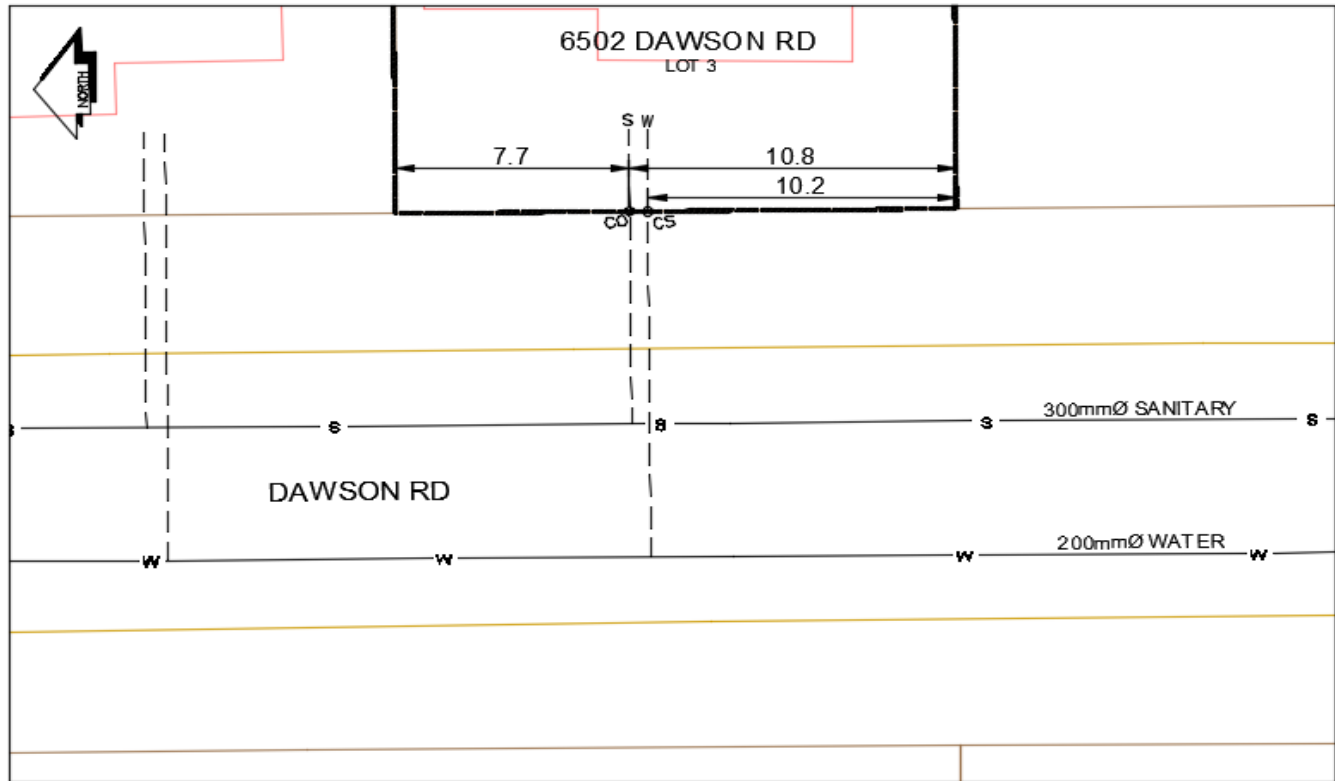

LEGEND:	CS CURB STOP	--- WATER SERVICE	--- STORM SERVICE
	CO CLEAN OUT	--- SANITARY SERVICE	--- GAS

NOT TO SCALE