
City of Prince George

HISTORY SHEET

PID: -	028396472	96472 Scale: 1:500							
Legal:	LOT 3				D.L.: - 1605			PLAN: - EPP8499	
Address:	- 2961 VISTA RII	OGE DR							
Sanitary Co	nnection:#	SIZE:	100mmØ	MATERIAL	PVC	INV.	670.33m	CONNECTED	
Water Conn	ection:#	SIZE:	19mmØ	MATERIAL:	COPPER	INV.	670.45m		
Storm Conn	ection:#	SIZE	100mmØ	MATERIAL	PVC	INV.	670.32m	CONNECTED	
Cash Recei	pt No's:		WATER		SANITARY	•		STORM	
CURB FROM PR	OPERTY LINE 5n	n					PAVEME	NT WIDTH 10m	
B.C. HYDRO	75mm DB2				U/G CONNEC	CTION	_/		
B.C. TELEPHON	E 50mm DB2				U/G CONNEC	CTION	_/		
TERASEN GAS	42 PROP /P.E								
Information	Sheets: REF.	DWGS.	L&M ENGINEE	RING LTD. JOB	. 1106-06-04	DWGS. (0	001-306)		
Comments:	CS CURB	STOP I OUT		WATER SERVICE STORM SERVICE SANITARY SERVICE SANITARY SERVICE	E - E - /ICE	HYDR	O SERVICE E SERVICE COMMUNICAS	— GAS — GAS STIONS — E — ELECTRICAL	

THE INFORMATION CONTAINED HEREIN IS FOR INTERNAL USE ONLY.

NOT TO BE RELIED UPON UNLESS CONFIRMED BY THE SITE INSPECTION AND/OR INVESTIGATION

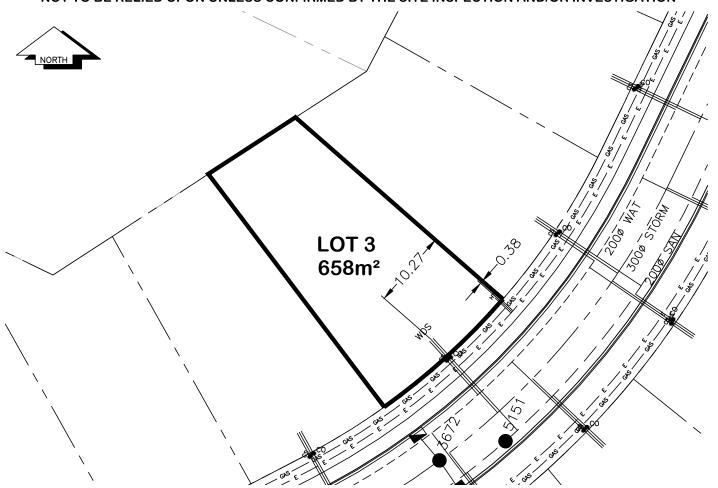

SANITARY, STORM & WATER SERVICE INVERTS	SANITARY	WATER	STORM
1. Distance from San. M.H. 5151 toward San. M.H. 5150 to lot service connection point is:	2.0m	N/A	N/A
1a.Distance from Stm. M.H. 3672 toward Stm. M.H. 3671 to lot service connection point is:	N/A	N/A	10.0m
2. Main Size at connection point is	200mmØ	200mmØ	300mmØ
3. Invert of main at conn. stub pt is	668.41m	668.53m	668.70m
4. Invert at service end is	670.33m	670.45m	670.32m
5. Cover at P/L in meters	2.31m	2.65m	2.43m
6. Survey Date: NOV,14,07Book Ref.: 1106-06-03By: FORESIGHT			
SANITARY HISTORY:			
DATE INSTALLED: JULY 2010			
INSTALLED BY: WESTERN INDUSTRIAL CONTRACTORS LTD			
WATER HISTORY:			
DATE INSTALLED: JULY 2010			
INSTALLED BY: WESTERN INDUSTRIAL CONTRACTORS LTD			
INSTALLED BY: WESTERN INDUSTRIAL CONTRACTORS ETD			
STORM HISTORY:			
DATE INSTALLED: JULY 2010			
INSTALLED BY: WESTERN INDUSTRIAL CONTRACTORS LTD			