

City of Prince George

HISTORY SHEET

PID: - 028396481 **Scale: 1:500**

Legal: LOT 4 **D.L.: -** 1605 **PLAN: -** EPP8499

Address: - 2967 VISTA RIDGE DR

Sanitary Connection:# **SIZE:** 100mmØ **MATERIAL** PVC **INV.** 668.53m **CONNECTED**

Water Connection:# **SIZE:** 19mmØ **MATERIAL:** COPPER **INV.** 668.65m

Storm Connection:# **SIZE** 100mmØ **MATERIAL** PVC **INV.** 668.54m **CONNECTED**

Cash Receipt No's: **WATER** **SANITARY** **STORM**

CURB FROM PROPERTY LINE 5m **PAVEMENT WIDTH** 10m

B.C. HYDRO 75mm DB2 **U/G CONNECTION** ✓

B.C. TELEPHONE 50mm DB2 **U/G CONNECTION** ✓


TERASEN GAS 42 PROP /P.E

Information Sheets: REF. DWGS. L&M ENGINEERING LTD. JOB. 1106-06-04 DWGS. (001-306)

Comments: CS CURB STOP SDW WATER SERVICE SDW HYDRO SERVICE
CO CLEAN OUT SDW STORM SERVICE SDW CABLE SERVICE
SDW SANITARY SERVICE SDW TELECOMMUNICATIONS GAS GAS
E ELECTRICAL

THE INFORMATION CONTAINED HEREIN IS FOR INTERNAL USE ONLY.

NOT TO BE RELIED UPON UNLESS CONFIRMED BY THE SITE INSPECTION AND/OR INVESTIGATION

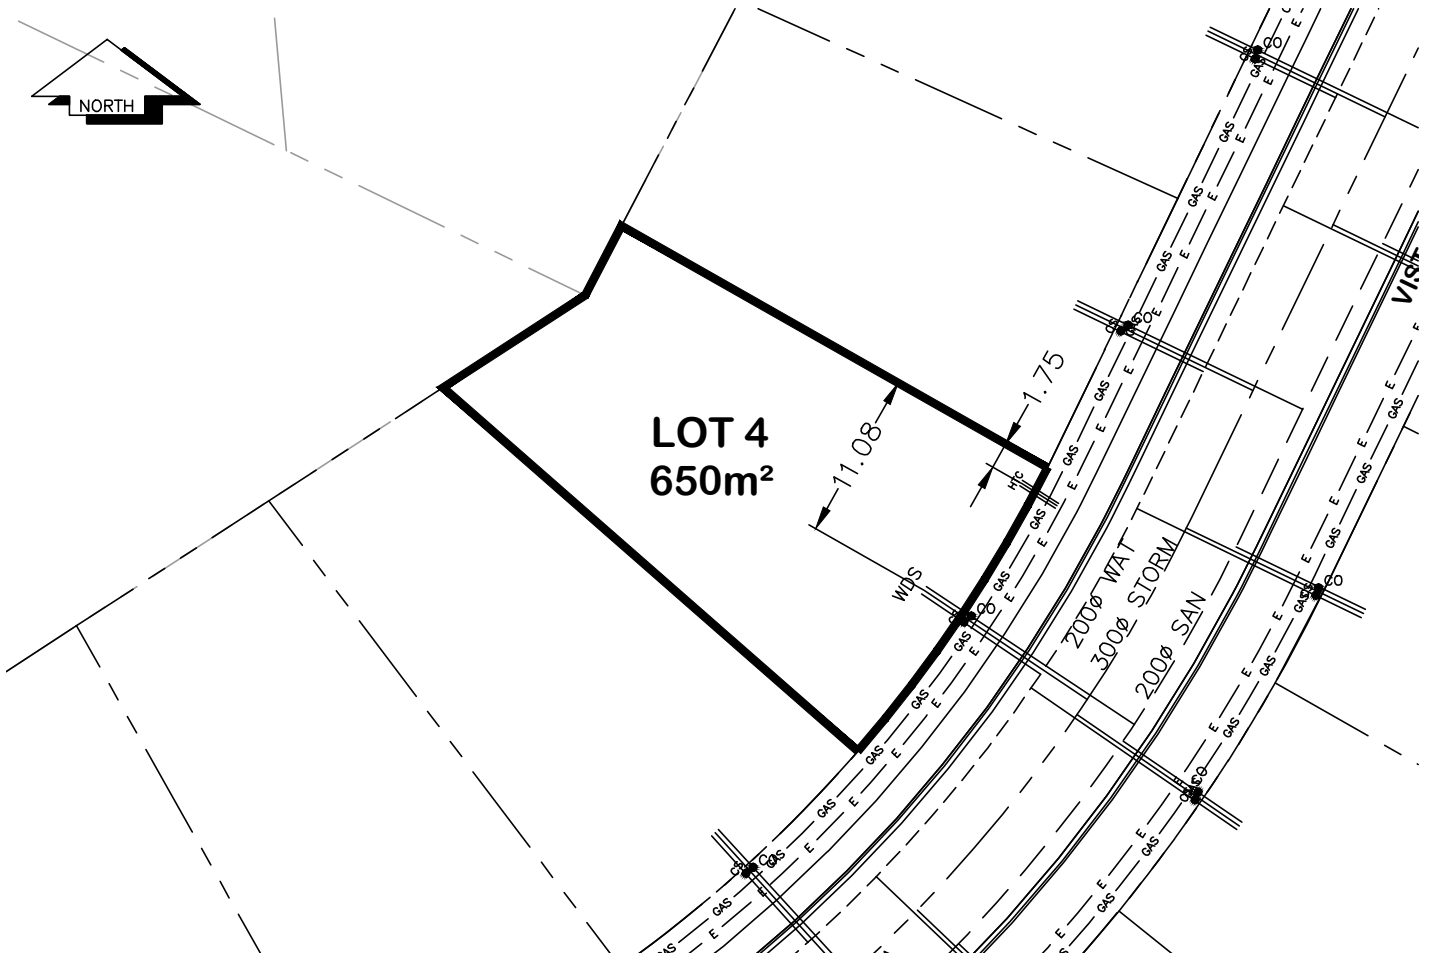

SANITARY, STORM & WATER SERVICE INVERTS	SANITARY	WATER	STORM
1. Distance from San. M.H5151 toward San. M.H. 5150 to lot service connection point is:	28.0m	N/A	N/A
1a.Distance from Stm. M.H. 3672 toward Stm. M.H. 3671 to lot service connection point is:	N/A	N/A	35.0m
2. Main Size at connection point is	200mmØ	200mmØ	300mmØ
3. Invert of main at conn. stub pt is	666.95m	667.50m	667.85m
4. Invert at service end is	668.53m	668.65m	668.54m
5. Cover at P/L in meters	2.49m	2.72m	2.49m
6. Survey Date: NOV,14,07Book Ref.: 1106-06-03By: FORESIGHT			

SANITARY HISTORY:

DATE INSTALLED: JULY 2010

INSTALLED BY: WESTERN INDUSTRIAL CONTRACTORS LTD

WATER HISTORY:

DATE INSTALLED: JULY 2010

INSTALLED BY: WESTERN INDUSTRIAL CONTRACTORS LTD

STORM HISTORY:

DATE INSTALLED: JULY 2010

INSTALLED BY: WESTERN INDUSTRIAL CONTRACTORS LTD
