
City of Prince George

HISTORY SHEET

PID: -	028396545			Scale: 1:500				
Legal:	LOT 9		D.L.: - 16).L.: - 160)5	PLAN: - EPP8499
Address: -	3003 VISTA RI	OGE DR						
Sanitary Co	nnection:#	SIZE:	100mmØ	MATERIAL	PVC	INV.	662.80m	CONNECTED
Water Conn	ection:#	SIZE:	19mmØ	MATERIAL:	COPPER	INV.	662.45m	
Storm Conn	ection:#	SIZE	100mmØ	MATERIAL	PVC	INV.	662.74m	CONNECTED
Cash Receipt No's:			WATER		SANITARY			STORM
CURB FROM PR	OPERTY LINE 5r	n					PAVEME	NT WIDTH 10m
B.C. HYDRO	75mm DB2				U/G CONNEC	CTION	/	
B.C. TELEPHON	E 50mm DB2				U/G CONNEC	CTION	_	
TERASEN GAS	42 PROP /P.E							
Information	Sheets: REF.	DWGS.	L&M ENGINEE	RING LTD. JOB	. 1106-06-04	DWGS. (0	001-306)	
Comments:	CS CURB	STOP NOUT		WATER SERVICE STORM SERVICE SANITARY SER	E - VICE -	HYDR	O SERVICE E SERVICE COMMUNICAS	— GAS — GAS STIONS — E — ELECTRICAL

THE INFORMATION CONTAINED HEREIN IS FOR INTERNAL USE ONLY.

NOT TO BE RELIED UPON UNLESS CONFIRMED BY THE SITE INSPECTION AND/OR INVESTIGATION

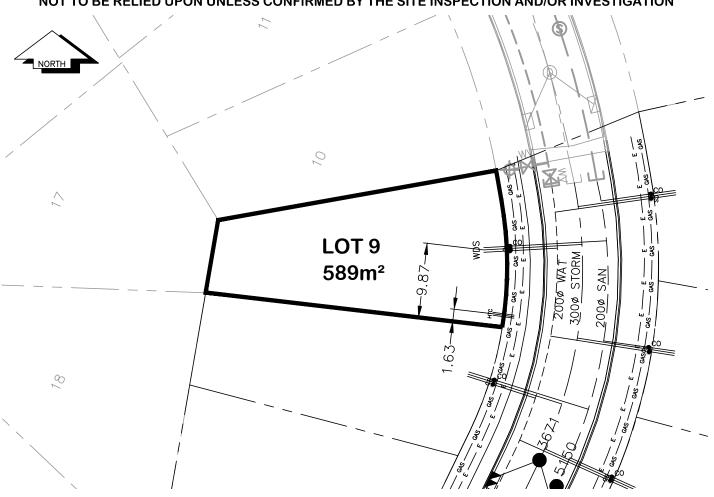

SANITARY, STORM & WATER SERVICE INVERTS	SANITARY	WATER	STORM								
1. Distance from San. M.H. 5150 toward San. M.H. 4459 to lot service connection point is:	34.0m	N/A	N/A								
1a.Distance from Stm. M.H.3671 toward Stm. M.H. 622 to lot service connection point is:	N/A	N/A	30.0m								
2. Main Size at connection point is	200mmØ	200mmØ	300mmØ								
3. Invert of main at conn. stub pt is	662.14m	661.35m	662.13m								
4. Invert at service end is	662.80m	662.45m	662.74m								
5. Cover at P/L in meters	2.03m	2.67m	2.09m								
6. Survey Date: NOV,14,07Book Ref.: 1106-06-03By: FORESIGHT											
	-		-								
SANITARY HISTORY:											
DATE INSTALLED: JULY 2010											
INSTALLED BY: WESTERN INDUSTRIAL CONTRACTORS LTD											
WATER HISTORY:											
DATE INSTALLED: JULY 2010											
INSTALLED BY: WESTERN INDUSTRIAL CONTRACTORS LTD											
STORM HISTORY:											
DATE INSTALLED: JULY 2010											
INSTALLED BY: WESTERN INDUSTRIAL CONTRACTORS LTD											