


City of Prince George

HISTORY SHEET

PID: -		028396553		Scale: 1:500	
Legal:		LOT 10		D.L.: - 1605	
				PLAN: - EPP8499	
Address:		3002 VISTA RIDGE DR			
Sanitary Connection:#		SIZE:	100mmØ	MATERIAL	PVC
				INV.	662.55m
					CONNECTED
Water Connection:#		SIZE:	19mmØ	MATERIAL:	COPPER
				INV.	662.32m
Storm Connection:#		SIZE	100mmØ	MATERIAL	PVC
				INV.	662.52m
					CONNECTED
Cash Receipt No's:		WATER		SANITARY	
				STORM	
CURB FROM PROPERTY LINE		5m		PAVEMENT WIDTH 10m	
B.C. HYDRO		75mm DB2		U/G CONNECTION ✓	
B.C. TELEPHONE		50mm DB2		U/G CONNECTION ✓	
TERASEN GAS		42 PROP /P.E			
Information Sheets:		REF. DWGS. L&M ENGINEERING LTD. JOB. 1106-06-04 DWGS. (001-306)			
Comments:		CS CURB STOP CO CLEAN OUT	SDW WATER SERVICE STORM SERVICE SANITARY SERVICE	HOI HYDRO SERVICE CABLE SERVICE TELECOMMUNICATIONS	GAS GAS E ELECTRICAL

THE INFORMATION CONTAINED HEREIN IS FOR INTERNAL USE ONLY.

NOT TO BE RELIED UPON UNLESS CONFIRMED BY THE SITE INSPECTION AND/OR INVESTIGATION

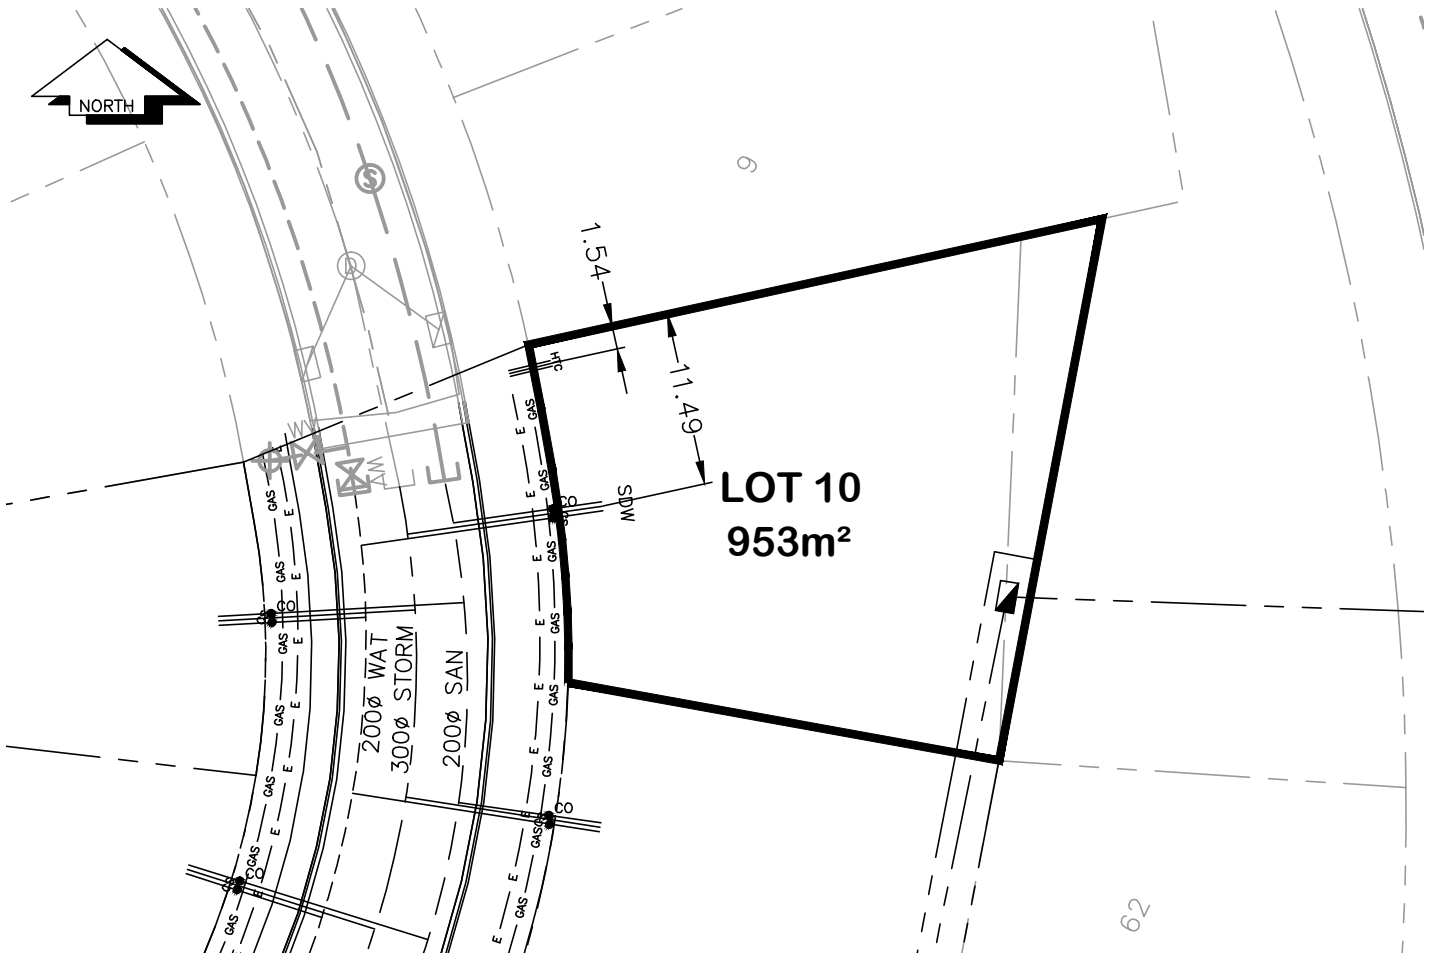

SANITARY, STORM & WATER SERVICE INVERTS	SANITARY	WATER	STORM
1. Distance from San. M.H. 5150 toward San. M.H. 4459 to lot service connection point is:	39.0m	N/A	N/A
1a.Distance from Stm. M.H. 3671 toward Stm. M.H. 622 to lot service connection point is:	N/A	N/A	36.0m
2. Main Size at connection point is	200mmØ	200mmØ	300mmØ
3. Invert of main at conn. stub pt is	662.10m	661.38m	662.21m
4. Invert at service end is	662.55m	662.32m	662.52m
5. Cover at P/L in meters	2.00m	2.34m	2.00m
6. Survey Date: NOV,14,07Book Ref.: 1106-06-03By: FORESIGHT			

SANITARY HISTORY:

DATE INSTALLED: JULY 2010

INSTALLED BY: WESTERN INDUSTRIAL CONTRACTORS LTD

WATER HISTORY:

DATE INSTALLED: JULY 2010

INSTALLED BY: WESTERN INDUSTRIAL CONTRACTORS LTD

STORM HISTORY:

DATE INSTALLED: JULY 2010

INSTALLED BY: WESTERN INDUSTRIAL CONTRACTORS LTD